

CERTIFIED RECORD OF LAND CORNER MONUMENTATION


R-19

History of original corner establishment:

Corner established by W. B. Barr under GLO contract no. 355 dated June 14, 1880.

Surveyor General records state:

Marked basalt rock 28 x 16 x 12" for 1/4 Sec corner.
Raised mound of rock as per instructions.

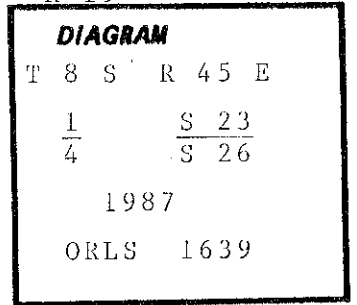

Description of corner evidence found:

Found stone 27 x 14 x 13" (record states 28 x 16 x 12) firmly set 6" in ground with small rock mound alongside. No marks identified.

Description of monument and accessories established to perpetuate the original location of this corner:

At position of found stone...Set 2 1/2" aluminum cap on 2" aluminum pipe 25" in ground with 5" projecting out of ground with surrounding rock mound and 6' fence post alongside with sign 54-9 attached. Buried original stone alongside.

No trees available, marked the following bearing objects...
A basalt boulder 36" x 20" projecting 24" out of ground bears S80 1/2° W, 121.2' dist marked BX0. A basalt boulder 30 x 30 x 24" bears N23° E, 214.1' dist marked BX0.

Bearing objects are painted with red band of paint.

Compass declination 20° East.

I hereby certify that the above described corner monument was properly remonumented by me and witnessed by Jim DeMastus on April 15, 1987.

REGISTERED
PROFESSIONAL
LAND SURVEYOR

William L. Hanley

OREGON
WILLIAM L. HANLEY
1939

Office of...County Surveyor..... County of...Baker.....
State of...Oregon....., I hereby certify that the within instrument was filed in this office
for record on the..... day of....., 19.....

..... by
(COUNTY OFFICIAL) (DEPUTY)

FILED 4/29/87
COUNTY SURVEYOR
8-45-98