

CERTIFIED RECORD OF LAND CORNER MONUMENTATION


R-25

**History of original corner establishment:**

Corner established by N. O. Walden under contract no. 198 and dated July 15, 1873.

Surveyor General records state:

Set basalt stone 20 x 12 x 4" in ground for corner to Secs 25, 30, 24 & 19.

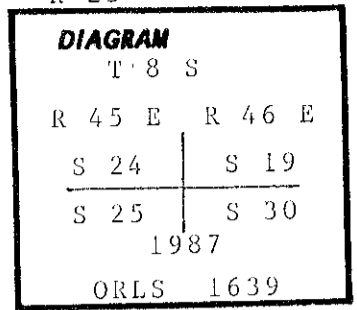

**Description of corner evidence found:**

Found large rock mound in rock jack from which very old remains of wooden fence line bear North & West - accepted center of rock jack as best available evidence for section corner.

**Description of monument and accessories established to perpetuate the original location of this corner:**

At center of rock mound in rock jack... Set 2 1/2" aluminum cap on 2" aluminum pipe 25" in ground with 5" projecting out of ground with surrounding rock mound and 6' fence post alongside with sign 54-9 attached. Buried original stone alongside.

There being no trees available, I marked the following bearing objects: A basalt boulder 30 x 20" projecting 30" out of ground bears N45°W, 57.2' dist marked "BX0". A basalt boulder 72 x 40" projecting 40" out of ground bears S75 1/2°W, 15.4' dist marked "BX0". Each bearing object is painted red.

Compass declination 20° East.

I hereby certify that the above described corner monument was properly remonumented by me and witnessed by Jim DeMastus on April 20, 1987.

REGISTERED PROFESSIONAL LAND SURVEYOR

*William L Hanley*

OREGON  
JULY 14, 1978  
WILLIAM L HANLEY  
1639

Office of.....County.....Surveyor..... County of.....Baker.....  
State of.....Oregon....., I hereby certify that the within instrument was filed in this office  
for record on the..... day of....., 19.....

..... by .....  
(COUNTY OFFICIAL) (DEPUTY)

FILED 4/29/87  
COUNTY SURVEYOR  
8-45-99