

CERTIFIED RECORD OF LAND CORNER MONUMENTATION


V-25

History of original corner establishment:

Corner established by N. O. Walden under contract no. 198 and dated July 15, 1873.

Surveyor General records state:

Set basalt rock 16 x 8 x 6", 8" in ground for corner to Secs 36, 31, 25 & 30.

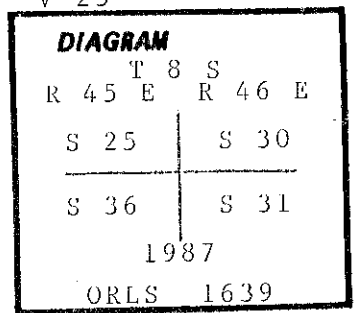

Description of corner evidence found:

Found undisturbed lone rock mound 4' in diameter and nearly flush with ground with stone 16 x 8 x 6" - no marks identified.

Description of monument and accessories established to perpetuate the original location of this corner:

At position of record size stone in center of mound of stones... Set 2½" aluminum cap on 2" aluminum pipe 25" in ground with 5" projecting out of ground with surrounding rock mound and 6' fence post alongside with sign 54-9 attached. Buried original stone alongside. There being no trees available, I marked the following bearing objects: A basalt boulder 36 x 24" projecting 12" out of ground bears N11½°E, 24.2' dist marked "BX0". A basalt boulder 50 x 20" projecting 30" out of ground bears N28°W, 103.5' dist marked "BX0". A basalt boulder 30 x 20" projecting 18" out of ground bears S58½°W, 110.0' dist marked "BX0". Each bearing object is painted red.

Compass declination 20° East.

I hereby certify that the above described corner monument was properly remonumented by me and witnessed by Jim DeMastus on April 20, 1987.

REGISTERED
PROFESSIONAL
LAND SURVEYOR

William L. Hanley

OREGON
JULY 14, 1978
WILLIAM L. HANLEY
1639

Office of...County...Surveyor..... County of...Baker.....
State of...Oregon....., I hereby certify that the within instrument was filed in this office
for record on the..... day of....., 19.....

..... by
(COUNTY OFFICIAL) (DEPUTY)

FILED 4/29/87

BAKER COUNTY SURVEYOR

SURVEY NO. 8-45-100