


CERTIFIED RECORD OF LAND CORNER MONUMENTATION

F-16

History of original corner establishment:

None. Corner established this survey.

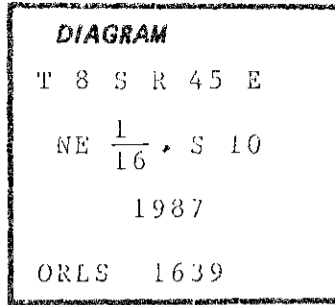

Description of corner evidence found:

None.

Description of monument and accessories I established to perpetuate the original location of this corner:

At position established by survey...

Set 2½" aluminum cap on 2" aluminum pipe 25" in ground with 5" projecting out of ground with earthen mound (no rocks available within limits) with fence post 3' West with signs 54-2 & 54-9. Cap marked as shown in corner diagram.

New bearing trees established:

A fir 17" diam bears S70°W, 50.1' dist marked NE1/16S10 BT.

A fir 15" diam bears S09°W, 34.8' dist marked NE1/16S10 BT.

Each new BT has a band of red paint, painted blaze, a brass washer marked PLS 1639 nailed flush to BT blaze and signs 54-3 & 54-9 attached.

Compass declination 20° East.

I hereby certify that the above described corner monument was properly established by me and witnessed by Jim DeMastus on April 29, 1987.

REGISTERED  
PROFESSIONAL  
LAND SURVEYOR

*William L. Hanley*

OREGON  
JULY 14, 1978  
WILLIAM L. HANLEY  
1639

Office of..... County Surveyor..... County of..... Baker  
Oregon  
State of....., I hereby certify that the within instrument was filed in this office  
for record on the..... day of....., 19.....  
..... by .....  
(COUNTY OFFICIAL) (DEPUTY)