


CERTIFIED RECORD OF LAND CORNER MONUMENTATION

G-14

History of original corner establishment:

None. Corner established this survey.

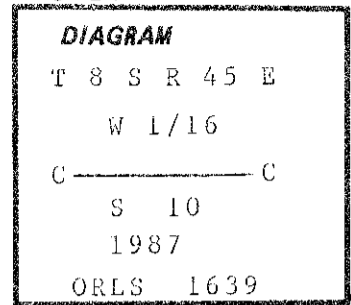

Description of corner evidence found:

None.

Description of monument and accessories established to perpetuate the original location of this corner:

At position established by survey...

Set 2½" aluminum cap on 2" aluminum pipe 25" in ground with 5" projecting out of ground with surrounding rock mound and 6' fence post alongside and signs 54-2 & 54-9. Cap marked as shown in corner diagram.

New bearing trees established:

A p pine 14" diam bears S60°W, 54.7' dist marked CW1/16S10 BT.

A p pine 13" diam bears S05½°E, 51.2' dist marked CW1/16S10 BT.

Each new BT has a band of red paint, painted blaze, a brass washer marked PLS 1639 nailed flush to BT blaze and signs 54-3 & 54-9 attached.

Compass declination 20° East.

I hereby certify that the above described corner monument was properly established by me and witnessed by Jim DeMastus on April 29, 1987.

**REGISTERED
PROFESSIONAL
LAND SURVEYOR**

William L. Hanley

OREGON
JULY 14, 1978
WILLIAM L. HANLEY
1639

Office of..... County Surveyor..... County of..... Baker
 State of..... Oregon....., I hereby certify that the within instrument was filed in this office
 for record on the..... day of....., 19.....
 by
 (COUNTY OFFICIAL) (DEPUTY)

FILED 5/13/87
 BAKER COUNTY SURVEYOR
 SURVEY NO. 8-45-103