

CERTIFIED RECORD OF LAND CORNER MONUMENTATION

G-21


History of original corner establishment:

Corner established by W. B. Barr under GLO contract No. 358 and dated June 14, 1880.

Surveyor General records state:

Marked a pine 8 ins diam for 1/4 Sec corner from which:

- Pine 6 ins diam bears S40°E, 104 lks dist.
- Pine 6 ins diam bears S50°W, 63 lks dist.

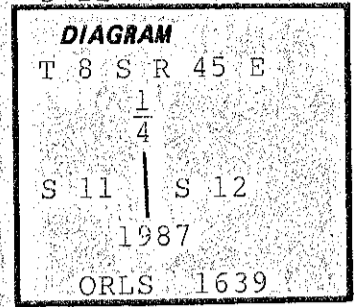

Description of corner evidence found:

Found a windblow snag 9" dia mkd "T" on partially healed and decaying lower blaze brs S50°W, 63 lks dist.
 A root stub with decaying stem fragment alongside marked 1/4S BT brs S04°E, 104 lks dist.

Description of monument and accessories I established to perpetuate the original location of this corner:

At position determined by reversed record bearing and distance from recovered original BTs...

Set 2 1/2" aluminum cap on 2" aluminum pipe 25" in ground with 5" projecting out of ground with surrounding rock mound and 6' fence post alongside with sign 54-9 attached. Cap marked as shown in diagram.

New bearing trees established:

- White fir 13" diam brs N53°W, 23.5' dist marked 1/4S11 BT.
- White fir 9" diam brs N24°E, 29.6' dist marked 1/4S12 BT.

Each new BT has a band of red paint, painted blaze, a brass washer marked PLS 1639 nailed flush to BT blaze and signs 54-3 & 54-9 attached.

Compass declination 20° East.

I hereby certify that the above described corner monument was properly remonumented by me and witnessed by Jim DeMastus on June 08, 1987.

**REGISTERED
PROFESSIONAL
LAND SURVEYOR**

William L. Hanley

**OREGON
JULY 14, 1978
WILLIAM L. HANLEY
1639**

Office of.....County Surveyor..... County of... Baker
 State of.....Oregon....., I hereby certify that the within instrument was filed in this office
 for record on the..... day of....., 19.....
 by
 (COUNTY OFFICIAL) (DEPUTY)