


CERTIFIED RECORD OF LAND CORNER MONUMENTATION

History of original corner establishment:

None. Corner established with this survey.

G-22

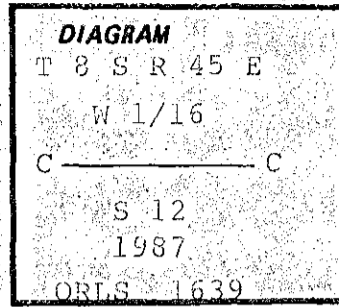

Description of corner evidence found:

None.

Description of monument and accessories I established to perpetuate the original location of this corner:

At position determined by survey....

Set 2½" aluminum cap on 2" aluminum pipe 25" in ground with 5" projecting out of ground with surrounding rock mound and 6' fence post alongside with sign 54-9 & 54-2 attached. Cap marked as shown in corner diagram.

New bearing trees established:

White fir 13" dia brs S68½°W, 23.5' dist mkd CW1/16S12 BT.
White fir 11" dia brs S66½°E, 23.3' dist mkd CW1/16S12 BT.

Each BT has a sign 54-3 and sign 54-9 attached below a 6" band of red paint, and each new BT has a brass washer marked PLS 1639 nailed flush with BT blaze.

Compass declination 19° East.

I hereby certify that the above described corner monument was properly established by me and witnessed by Jim DeMastus on June 30, 1987.

**REGISTERED
PROFESSIONAL
LAND SURVEYOR**

William L. Hanley

**OREGON
JULY 14, 1978
WILLIAM L. HANLEY
1639**

Office of..... County Surveyor..... County of..... Baker

State of..... Oregon, I hereby certify that the within instrument was filed in this office

for record on the..... day of....., 19.....

..... by

(COUNTY OFFICIAL)

(DEPUTY)