


CERTIFIED RECORD OF LAND CORNER MONUMENTATION

History of original corner establishment:

None. Corner established with this survey.

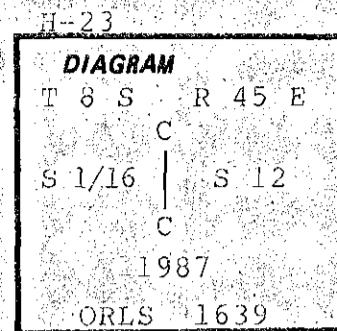

Description of corner evidence found:

None.

Description of monument and accessories established to perpetuate the original location of this corner:

At position determined by survey....

Set 2 1/2" aluminum cap on 2" aluminum pipe 20" in ground with 10" projecting out of ground with surrounding rock mound and 6' fence post alongside with sign 54-9 & 54-2 attached. Cap marked as shown in corner diagram.

New bearing trees established:

Ponderosa pine 21" dia brs S21°E, 96.4' dist mkd CS1/16S12 BT.

Ponderosa pine 15" dia brs S26°W, 90.8' dist mkd CS1/16S12 BT.

Each BT has a sign 54-3 and sign 54-9 attached below a 6" band of red paint, and each new BT has a brass washer marked PLS 1639 nailed flush with BT blaze.

Compass declination 19° East.

I hereby certify that the above described corner monument was properly established by me and witnessed by Jim DeMastus on July 01, 1987.

REGISTERED  
PROFESSIONAL  
LAND SURVEYOR

*William L. Hanley*

OREGON  
JULY 14, 1978  
WILLIAM L. HANLEY  
1639

Office of..... County Surveyor..... County of..... Baker  
Oregon  
State of....., I hereby certify that the within instrument was filed in this office  
for record on the..... day of....., 19.....

..... by .....  
(COUNTY OFFICIAL) (DEPUTY)

Form R6-7100-57 (9/71)

FILED 12-3-87  
BAKER COUNTY SURVEYOR  
SURVEY NO. 8-45-113

GPO-791-311