


CERTIFIED RECORD OF LAND CORNER MONUMENTATION

H-24

History of original corner establishment:

None. Corner established with this survey.

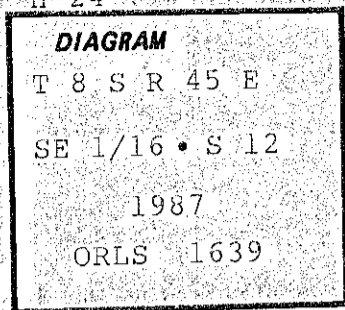

Description of corner evidence found:

None.

Description of monument and accessories established to perpetuate the original location of this corner:

At position determined by survey....

Set 2½" aluminum cap on 2" aluminum pipe 25" in ground with 5" projecting out of ground with surrounding rock mound and 6' fence post alongside with sign 54-9 & 54-2 attached. Cap marked as shown in corner diagram.

New bearing trees established.

A poplar 8" dia brs N49°W, 41.1' dist mkd SE1/16S12 BT (bark scribed).
A poplar 11" dia brs S35½°W, 37.0' dist mkd SE1/16S12 BT (bark scribed).

Each BT has a sign 54-3 and sign 54-9 attached below a 6" band of red paint, and each new BT has a brass washer marked PLS 1639 nailed flush with BT blaze.

Compass declination 19° East.

I hereby certify that the above described corner monument was properly established by me and witnessed by Jim DeMastus on July 01, 1987.

REGISTERED
PROFESSIONAL
LAND SURVEYOR

William L. Hanley

OREGON
JULY 14, 1978
WILLIAM L. HANLEY
1639

Office of.....County...Surveyor..... County of.....Baker.....

State of.....Oregon....., I hereby certify that the within instrument was filed in this office

for record on the..... day of....., 19.....

..... by

(COUNTY OFFICIAL)

(DEPUTY)

FILED 12-3-87

BAKER COUNTY SURVEYOR

SURVEY NO. 8-45-114