

CERTIFIED RECORD OF LAND CORNER MONUMENTATION


J-19

History of original corner establishment:

Corner established by W.B. Barr under GLO contract no. 358 dated June 14, 1880.

Surveyor General records state:

Marked basalt rock 14 x 14 x 6 ins for 1/4 sec corner, raised mound of rock as per instructions.

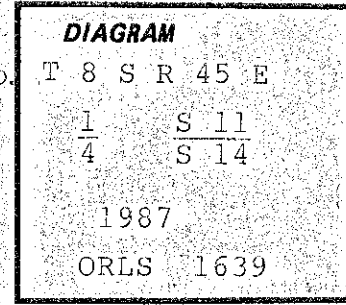

Description of corner evidence found:

No trace of original basalt rock or mound, searched 10 man hours of diligent and thorough search on three occasions.

Description of monument and accessories established to perpetuate the original location of this corner:

At point midway between adjacent section corners East & West as determined by survey...

Set 2 1/2" aluminum cap on 2" aluminum pipe 25" in ground with 5" projecting out of ground with surrounding rock mound and 6' steel fence post alongside with sign 54-9 attached.

New bearing trees established:

Ponderosa pine 12" diam brs N04°E, 7.0' dist marked 1/4S11 BT.

Ponderosa pine 13" diam brs S53°E, 45.8' dist marked 1/4S14 BT.

Each new BT has a band of red paint, painted blaze, a brass washer marked PLS 1639 nailed flush to BT blaze and signs 54-3 & 54-9 attached.

Compass declination 20° East.

I hereby certify that the above described corner monument was properly reestablished by me and witnessed by Jim DeMastus on June 01, 1987.

REGISTERED
PROFESSIONAL
LAND SURVEYOR

William L. Hanley

OREGON
JULY 14, 1978
WILLIAM L. HANLEY
1639

Office of County Surveyor..... County of Baker.....
State of Oregon.....

I hereby certify that the within instrument was filed in this office
for record on the..... day of....., 19.....

..... by

(COUNTY OFFICIAL)

(DEPUTY)