


CERTIFIED RECORD OF LAND CORNER MONUMENTATION

J-23

History of original corner establishment:

Corner established by W. B. Barr under GLO contract No. 358 and dated June 14, 1880.
Surveyor General records state:
Marked basalt rock 12 x 12 x 8" for 1/4 Sec corner.
Raised mound of rock as per instructions.

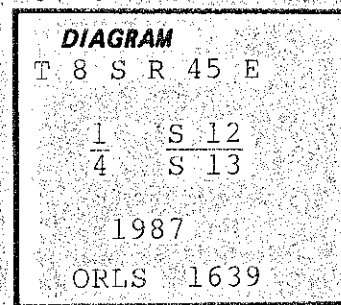

Description of corner evidence found:

Did not find original stone or mound after thorough and diligent search.

Description of monument and accessories established to perpetuate the original location of this corner:

At position midway between adjacent section corners East and West as determined by survey...
Set 2 1/2" aluminum cap on 2" aluminum pipe 25" in ground with 5" projecting out of ground with surrounding earth mound and 6' fence post alongside with sign 54-9 attached. (no stones available within limits)
Cap marked as shown in diagram.
New bearing trees established:
Ponderosa pine 8" diam brs N05°E, 41.4' dist marked 1/4S12 BT.
Ponderosa pine 13" diam brs S32°E, 27.3' dist marked 1/4S13 BT.
Each new BT has a band of red paint, painted blaze, a brass washer marked PLS 1639 nailed flush to BT blaze and signs 54-3 & 54-9 attached.
Compass declination 20° East.

I hereby certify that the above described corner monument was properly re-established by me and witnessed by Jim DeMastus on June 18, 1987.

REGISTERED
PROFESSIONAL
LAND SURVEYOR

William L. Hanley

OREGON
JULY 14, 1978
WILLIAM L. HANLEY
1639

Office of... County Surveyor..... County of... Baker
Oregon
State of..... I hereby certify that the within instrument was filed in this office
for record on the..... day of....., 19.....
..... by
(COUNTY OFFICIAL) (DEPUTY)