

CERTIFIED RECORD OF LAND CORNER MONUMENTATION


L-21

History of original corner establishment:

Corner established by W.B. Barr under GLO contract no. 358 dated June 14, 1880.

Surveyor General records state:

Marked pine 18 in diam for 1/4 Sec corner from which:
Pine 24 in diam bears N45°E, 45 lks dist.

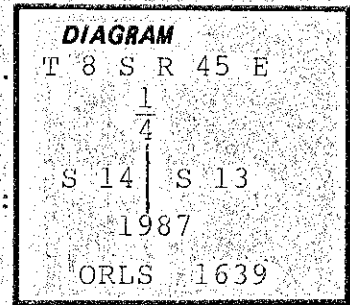

Description of corner evidence found:

No trace of original corner tree or BT on steep East face marked by logging and low-cut stumps.

Description of monument and accessories I established to perpetuate the original location of this corner:

At point midway between adjacent section corners North & South as determined by survey...

Set 2 1/2" aluminum cap on 2" aluminum pipe 20" in ground with 10" projecting out of ground with surrounding rock mound and 6' steel fence post alongside with sign 54-9 attached.

New bearing trees established:

Ponderosa pine 13" diam brs N21°E, 38.7' dist marked 1/4S13 BT.

Ponderosa pine 6" diam brs N69 1/2°W, 45.2' dist marked 1/4S14 BT.

Each new BT has a band of red paint, painted blaze, a brass washer marked PLS 1639 nailed flush to BT blaze and signs 54-3 & 54-9 attached.

Compass declination 20° East.

I hereby certify that the above described corner monument was properly reestablished by me and witnessed by Jim DeMastus on June 01, 1987.

**REGISTERED
PROFESSIONAL
LAND SURVEYOR**

William L. Hanley

**OREGON
JULY 14, 1978
WILLIAM L. HANLEY
1639**

Office of...County Surveyor..... County of...Baker.....
State of...Oregon....., I hereby certify that the within instrument was filed in this office
for record on the..... day of....., 19.....

(COUNTY OFFICIAL)

(DEPUTY)

FILED 12-3-87
BAKER COUNTY SURVEYOR
SURVEY NO. 8-45-120