


CERTIFIED RECORD OF LAND CORNER MONUMENTATION

**History of original corner establishment:**

None. Corner established with this survey.

L-24

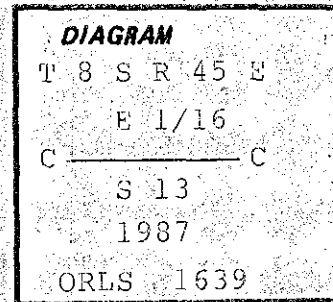

**Description of corner evidence found:**

None.

**Description of monument and accessories | established to perpetuate the original location of this corner:**

At position established by subdivision of section 13 as determined by survey...

Set 2½" aluminum cap on 2" aluminum pipe 25" in ground with 5" projecting out of ground with surrounding earth mound and 6' fence post alongside with sign 54-9 & 54-2 attached. Cap marked as shown in corner diagram.

**New bearing trees established:**

Ponderosa pine 16" dia brs S18°W, 20.3' dist mkd CE1/16S13 BT.  
Ponderosa pine 13" dia brs S88°W, 43.7' dist mkd CE1/16S13 BT.

Each BT has a sign 54-3 and sign 54-9 attached below a 6" band of red paint, and each new BT has a brass washer marked PLS 1639 nailed flush with BT blaze.

Compass declination 19° East.

I hereby certify that the above described corner monument was properly established by me and witnessed by Jim DeMastus on June 29, 1987.

REGISTERED  
PROFESSIONAL  
LAND SURVEYOR

*William L. Hanley*

OREGON  
JULY 14, 1978  
WILLIAM L. HANLEY  
1639