


CERTIFIED RECORD OF LAND CORNER MONUMENTATION

L-25

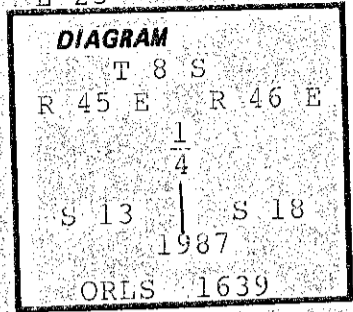

History of original corner establishment:

Corner established by N.O. Walden under contract No. 198 and dated July 1873.

Surveyor General records state:

Set basalt stone 15 x 8 x 5 ins. 8 ins. in ground for 1/4 Sec corner from which:

A fir 36 in dia bears S80°E, dist 104 lks.

Description of corner evidence found:

Did not find original stone or BT, in previously logged area.

NOTE: This original corner has been previously searched and declared lost as indicated on record of Baker County Survey Nos. 8-46-18 (October 14, 1974) and 8-46-27 (August 15, 1980).

Description of monument and accessories established to perpetuate the original location of this corner:

At position established by survey midway between adjacent section corners on range line north and south...

Set 2 1/2" aluminum cap on 2" aluminum pipe 25" in ground with 5" projecting out of ground with surrounding rock mound and 6' fence post alongside with sign 54-9 attached. Cap marked as shown in corner diagram.

New bearing trees established:

- Ponderosa pine 11" dia brs S46°E, 33.2' dist mkd 1/4S18 BT.
- Ponderosa pine 15" dia brs S49°W, 60.7' dist mkd 1/4S13 BT.

Each BT has a sign 54-3 and sign 54-9 attached below a 6" band of red paint, and each new BT has a brass washer marked PLS 1639 nailed flush with BT blaze.

Compass declination 19° East.

I hereby certify that the above described corner monument was properly reestablished by me and witnessed by Jim DeMastus on June 16, 1987.

REGISTERED PROFESSIONAL LAND SURVEYOR

William L. Hanley

OREGON JULY 14, 1978 WILLIAM L. HANLEY 1639

Office of.....County Surveyor..... County of..... Baker.....
 State of..... Oregon..... I hereby certify that the within instrument was filed in this office
 for record on the..... day of....., 19.....
 by..... (DEPUTY)
 (COUNTY OFFICIAL)