


CERTIFIED RECORD OF LAND CORNER MONUMENTATION

M-25

History of original corner establishment:

None. Corner established with this survey.

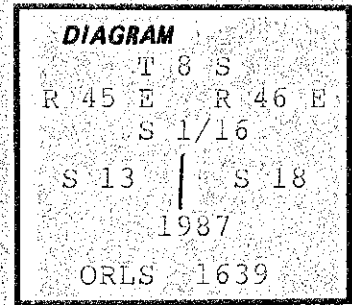

Description of corner evidence found:

None.

Description of monument and accessories established to perpetuate the original location of this corner:

At position midway between adjacent quarter section corner north and adjacent section corner south as determined by survey...

Set 2 1/2" aluminum cap on 2" aluminum pipe 25" in ground with 5" projecting out of ground with surrounding rock mound and 6' fence post alongside with sign 54-9 attached. Cap marked as shown in corner diagram.

New bearing trees established:

Ponderosa pine 9" dia brs S71 1/2° E, 20.5' dist mkd S1/16S18 BT.
White fir 10" dia brs S62 1/4° W, 16.8' dist mkd S1/16S13 BT.

Each BT has a sign 54-3 and sign 54-9 attached below a 6" band of red paint, and each new BT has a brass washer marked PLS 1639 nailed flush with BT blaze.

Compass declination 19° East.

I hereby certify that the above described corner monument was properly established by me and witnessed by Jim DeMastus on June, 16, 1987.

**REGISTERED
PROFESSIONAL
LAND SURVEYOR**

William L. Hanley

**OREGON
JULY 14, 1978
WILLIAM L. HANLEY
1639**

Office of..... County Surveyor..... County of..... Baker
Oregon..... State of..... I hereby certify that the within instrument was filed in this office
for record on the..... day of....., 19.....

(COUNTY OFFICIAL)

(DEPUTY)

FILED 12-3-87
BAKER COUNTY SURVEYOR
SURVEY NO. 8-45-125