

CERTIFIED RECORD OF LAND CORNER MONUMENTATION


N-17

History of original corner establishment:

Corner established by W.B. Barr under GLO contract No. 358 and dated June 14, 1880.

Surveyor General records state:

Marked basalt rock 20 x 15 x 8 for corner to Secs 14, 15, 22 & 23. Raised mound of rock as per instructions.

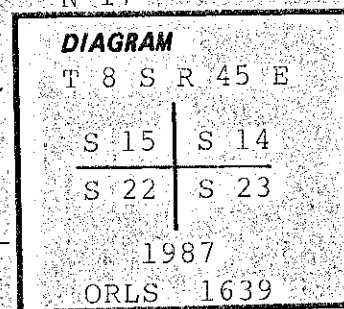

Description of corner evidence found:

Did not find corner stone or mound after thorough and diligent search.

Description of monument and accessories I established to perpetuate the original location of this corner:

At position established by double proportionate measurement from adjacent section corners North and South and adjacent quarter section corners East and West determined by survey...

Set 2 1/2" aluminum cap on 2" aluminum pipe 15" in ground with 15" projecting out of ground with surrounding rock mound and 6' fence post alongside with sign 54-9 attached.

There being no trees available within limits, I marked the following bearing objects... A basalt boulder 44 x 28 x 16" brs S20 1/2 W, 74.3' dist mkd BXO on its top center. A basalt boulder 40 x 36 x 30" brs S16 0 E, 72.6' dist mkd BXO on its West center top. A basalt boulder 60 x 22 x 22" brs N09 0 E, 68.5' dist mkd BXO on its center top. Each bearing object is painted red.

Compass declination 20 0 East.

I hereby certify that the above described corner monument was properly re-established by me and witnessed by Jim DeMastus on June 11, 1987.

**REGISTERED
PROFESSIONAL
LAND SURVEYOR**

William L. Hanley

OREGON
JULY 14, 1978
WILLIAM L. HANLEY
1639

Office of.....County Surveyor..... County of..... Baker.....
State of..... Oregon....., I hereby certify that the within instrument was filed in this office
for record on the..... day of....., 19.....
..... by
(COUNTY OFFICIAL) (DEPUTY)