

CERTIFIED RECORD OF LAND CORNER MONUMENTATION


P-17

History of original corner establishment:

Corner established by W.B.Barr under GLO contract No. 358 and dated June 14, 1880.

Surveyor General records state:

Marked basalt rock 20 x 12 x 10 for 1/4 Sec corner.
Raised mound of rock as per instructions.

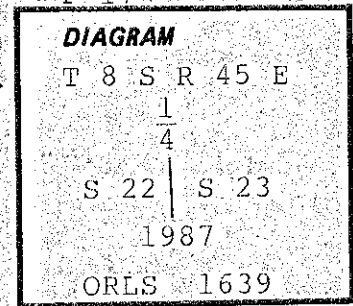

Description of corner evidence found:

Did not find corner stone or mound after thorough and diligent search.

Description of monument and accessories I established to perpetuate the original location of this corner:

At position midway between adjacent section corners North and South as determined by survey...

Set 2 1/2" aluminum cap on 2" aluminum pipe 20" in ground with 10" projecting out of ground with surrounding rock mound and 6' fence post alongside with sign 54-9 attached. Cap marked as shown in diagram.

There being no trees available within limits, I marked the following bearing objects... A basalt boulder 30 x 20 x 12" brs N04° W, 56.7' dist mkd BXO on its center top. A basalt boulder 20 x 16 x 12" brs N77° E, 82.5' dist mkd BXO on its center top.

Each bearing object is painted red.

Compass declination 20° East.

I hereby certify that the above described corner monument was properly re-established by me and witnessed by Jim DeMastus on June 11, 1987.

REGISTERED
PROFESSIONAL
LAND SURVEYOR

William L. Hanley

OREGON
JULY 14, 1978
WILLIAM L. HANLEY
1639

Office of..... County Surveyor..... County of..... Baker
Oregon
State of....., I hereby certify that the within instrument was filed in this office
for record on the..... day of....., 19.....
..... by
(COUNTY OFFICIAL) (DEPUTY)