

**CERTIFIED RECORD OF LAND CORNER MONUMENTATION**


P-21

**History of original corner establishment:**

Corner established by W.B. Barr under GLO contract No. 358 and dated June 14, 1880.

**Surveyor General records state:**

Marked basalt rock 12 x 12 x 6 ins for 1/4 Sec corner, raised mound of rock as per instructions from which:  
Fir 4 ins diam bears N20°E, 75 lks dist.

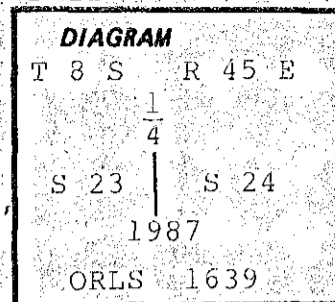

**Description of corner evidence found:**

Did not find stone or BT after thorough and diligent search.

**Description of monument and accessories I established to perpetuate the original location of this corner:**

At position established by survey midway between adjacent section corners North and South...

Set 2 1/2" aluminum cap on 2" aluminum pipe 25" in ground with 5" projecting out of ground with surrounding rock mound and 6' fence post alongside with sign 54-9 attached. Cap marked as shown in diagram.

**New bearing trees established:**

White fir 8" diam brs N47°E, 19.0' dist marked 1/4S24 BT.  
White fir 13" diam brs N43°W, 44.2' dist marked 1/4S23 BT.

Each new BT has a band of red paint, painted blaze, a brass washer marked PLS 1639 nailed flush to BT blaze and signs 54-3 & 54-9 attached.

Compass declination 20° East.

I hereby certify that the above described corner monument was properly re-established by me and witnessed by Jim DeMastus on June 10, 1987.

**REGISTERED  
PROFESSIONAL  
LAND SURVEYOR**

*William L. Hanley*

OREGON  
JULY 14, 1978  
WILLIAM L. HANLEY  
1639

Office of.....County Surveyor..... County of Baker.....  
State of Oregon, I hereby certify that the within instrument was filed in this office  
for record on the..... day of....., 19.....  
..... by .....  
(COUNTY OFFICIAL) (DEPUTY)

Form R6-7100-57 (9/71)

FILED 12-3-87  
BAKER COUNTY SURVEYOR  
SURVEY NO. 8-45-130

GPO-791-311