

CERTIFIED RECORD OF LAND CORNER MONUMENTATION


P-25

**History of original corner establishment:**

Corner established by N.O.Walden under GLO contract No. 198 and dated July 15, 1873.

Surveyor General records state:

Set basalt stone 16 x 8 x 5 ins 8 ins in ground for 1/4 Sec Cor.

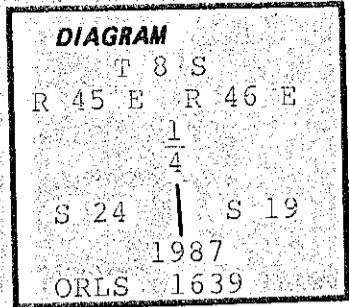

**Description of corner evidence found:**

Did not find original stone or mound alongside abandoned and down fence line with rock jacks nearby North and South.

**Description of monument and accessories established to perpetuate the original location of this corner:**

At position established by survey midway between adjacent section corners North and South...

Set 2 1/2" aluminum cap on 2" aluminum pipe 20" to bedrock with 10" projecting out of ground with surrounding rock mound and 6' fence post alongside with sign 54-9 attached. Cap marked as shown in diagram.

There being no trees available within limits, I marked the following bearing objects... A basalt boulder 32 x 22 x 15" brs N49° W, 35.7' dist mkd "BXO" on its top center. A basalt boulder 36 x 26 x 14" brs N26° E, 45.5' dist mkd "BXO" on its top center. Each bearing object is painted red.

Compass declination 19° East.

I hereby certify that the above described corner monument was properly re-established by me and witnessed by Jim DeMastus on June 8, 1987.

REGISTERED  
PROFESSIONAL  
LAND SURVEYOR

*William L. Hanley*

OREGON  
JULY 14, 1978  
WILLIAM L. HANLEY  
1639

Office of..... County Surveyor..... County of..... Baker.....  
 State of..... Oregon..... I hereby certify that the within instrument was filed in this office  
 for record on the..... day of....., 19.....  
 ..... by .....  
 (COUNTY OFFICIAL) (DEPUTY)

FILED 12-3-87

BAKER COUNTY SURVEYOR  
SURVEY NO. 8-45-131