

CERTIFIED RECORD OF LAND CORNER MONUMENTATION


R-23

History of original corner establishment:

Corner established by W.B. Barr under GLO contract No. 358 and dated June 14, 1880.

Surveyor General records state:

Marked basalt rock 12 x 8 x 8 for 1/4 Sec. cor.
Raised mound of rock as per instructions.

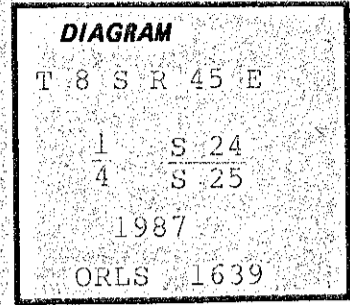

Description of corner evidence found:

Did not find stone or mound after thorough and diligent search.

Description of monument and accessories I established to perpetuate the original location of this corner:

At position midway between adjacent section corners east and west as determined by survey...

Set 2 1/2" aluminum cap on 2" aluminum pipe 6" below surface of north road shoulder and a 6' fence post alongside with sign 54-9 attached.

There being no trees within limits I marked the following bearing objects: A basalt ledge rock 48 x 38 x 12" brs N42° E, 39.7' dist mkd BXO on its north center top. The center top of south sign standard of entering/leaving Wallowa-Whitman National forest sign brs S20 1/2° E, 99.0' dist with brass washer marked PLS 1639 nailed flush with center top of sign standard.

Compass declination 17° East.

I hereby certify that the above described corner monument was properly reestablished by me and witnessed by Jim DeMastus on June 10, 1987.

REGISTERED
PROFESSIONAL
LAND SURVEYOR

William L. Hanley

OREGON
JULY 14, 1978
WILLIAM L. HANLEY
1639

Office of..... County Surveyor..... County of Baker
Oregon
State of..... I hereby certify that the within instrument was filed in this office
for record on the..... day of....., 19.....

(COUNTY OFFICIAL)

(DEPUTY)

FILED 12-3-87
BAKER COUNTY SURVEYOR
SURVEY NO. 8-45-133