

**CERTIFIED RECORD OF LAND CORNER MONUMENTATION**


T-17

**History of original corner establishment:**

Corner established by W.B. Barr under GLO contract No. 358 and dated June 14, 1880.

Surveyor General records state:

Marked basalt rock 22 x 18 x 12" for 1/4 Sec corner.  
Raised mound of rock as per instructions.

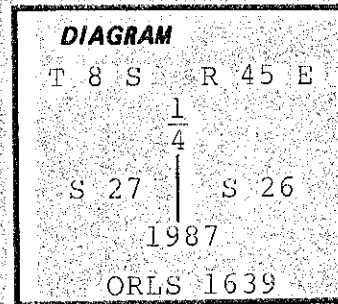

**Description of corner evidence found:**

Did not find corner stone or mound after thorough and diligent search.

**Description of monument and accessories I established to perpetuate the original location of this corner:**

At position midway between adjacent section corners North and South as determined by survey...

Set 2 1/2" aluminum cap on 2" aluminum pipe 15" in ground to bedrock, 15" projecting out of ground with surrounding rock mound and 6' fence post alongside with sign 54-9 attached. Cap marked as shown in diagram.

There being no trees available within limits, I marked the following bearing objects... A basalt boulder 32 x 22 x 12" brs S53°E, 128.9' dist mkd BXO on its center top. A basalt boulder 27 x 27 x 20" brs S15 1/2°W, 153.8' dist mkd BXO on its South face.

Each bearing object is painted red.

Compass declination 20° East.

I hereby certify that the above described corner monument was properly re-established by me and witnessed by Jim DeMastus on June 12, 1987.

REGISTERED  
PROFESSIONAL  
LAND SURVEYOR

*William L. Hanley*

OREGON  
JULY 14, 1978  
WILLIAM L. HANLEY  
1639

Office of..... County Surveyor..... County of Baker  
Oregon  
State of....., I hereby certify that the within instrument was filed in this office  
for record on the..... day of....., 19.....  
..... by .....

(COUNTY OFFICIAL)

(DEPUTY)