

CERTIFIED RECORD OF LAND CORNER MONUMENTATION


T-25

History of original corner establishment:

Corner established by N.O.Walden under GLO contract No. 198 and dated July 15, 1873.

Surveyor General records state:

Set basalt stone 12 x 8 x 8 ins 8 ins in ground for 1/4 Sec Cor.

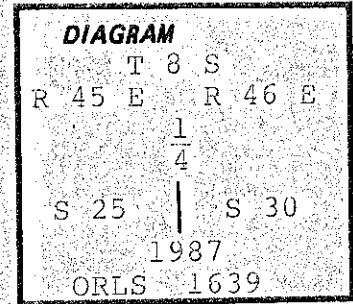

Description of corner evidence found:

Did not find original stone or mound on rock strewn hillside.

Description of monument and accessories I established to perpetuate the original location of this corner:

At position established by survey midway between adjacent section corners North and South...

Set 2 1/2" aluminum cap on 2" aluminum pipe 15" to bedrock with 15" projecting out of ground with surrounding rock mound and 6' fence post alongside with sign 54-9 attached. Cap marked as shown in diagram.

There being no trees available within limits, I marked the following bearing objects... A basalt boulder 36 x 26 x 10" brs N62° E, 5.5' dist mkd "BXO" on its center top. A basalt boulder 26 x 20 x 16" brs S32° W, 116.4' dist mkd "BXO" on its North-east face. Each bearing object is painted red.

Compass declination 19° East.

I hereby certify that the above described corner monument was properly re-established by me and witnessed by Jim DeMastus on June 8, 1987.

REGISTERED PROFESSIONAL LAND SURVEYOR

William L. Hanley

OREGON JULY 14, 1978 WILLIAM L. HANLEY 1639

Office of..... County Surveyor..... County of Baker
Oregon
State of..... I hereby certify that the within instrument was filed in this office for record on the..... day of....., 19.....
..... by
(COUNTY OFFICIAL) (DEPUTY)

FILED 12-3-87
BAKER COUNTY SURVEYOR
SURVEY NO. 8-45-136