

**CERTIFIED RECORD OF LAND CORNER MONUMENTATION**


V-23

**History of original corner establishment:**

Corner established by W.B.Barr under GLO contract No. 358 and dated June 14, 1880.

Surveyor General records state:

Marked basalt rock 26 x 14 x 6 ins for 1/4 Sec corner, raised mound of rock as per instructions.

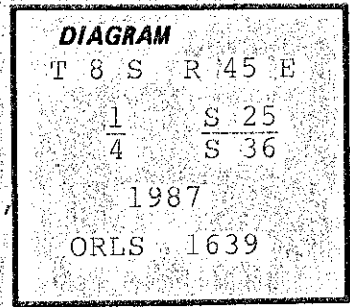

**Description of corner evidence found:**

Did not find corner stone or mound after thorough and diligent search.

**Description of monument and accessories established to perpetuate the original location of this corner:**

At position midway between adjacent section corners East and West as determined by survey...

Set 2 1/2" aluminum cap on 2" aluminum pipe 20" in ground with 10" projecting out of ground with surrounding rock mound and 6' fence post alongside with sign 54-9 attached. Cap marked as shown in diagram.

There being no trees within limits, bearing objects established: A basalt boulder 36 x 36 x 36" brs N30° E, 189.0' dist mkd "BXO" on its center top. A small basalt ledger rock 35 x 18 x 12" brs S50° W, 134.0' dist mkd "BXO" on its top center.

Each bearing object is painted red.

Compass declination 20° East.

I hereby certify that the above described corner monument was properly re-established by me and witnessed by Jim DeMastus on June 10, 1987.

**REGISTERED  
PROFESSIONAL  
LAND SURVEYOR**

*William L. Hanley*

**OREGON  
JULY 14, 1978  
WILLIAM L. HANLEY  
1639**

Office of..... County Surveyor..... County of Baker

State of..... Oregon..... I hereby certify that the within instrument was filed in this office for record on the..... day of....., 19.....

..... by  
(COUNTY OFFICIAL)

.....  
(DEPUTY)

FILED 12-3-87

BAKER COUNTY SURVEYOR

SURVEY NO. 8-45-137