

CERTIFIED RECORD OF LAND CORNER MONUMENTATION


X-25

History of original corner establishment:

Corner established by N.O.Walden under GLO contract No. 198 and dated July 15, 1873.

Surveyor General records state:

Set basalt stone 14 x 14 x 6 ins 8 ins in ground for 1/4 Sec Cor.

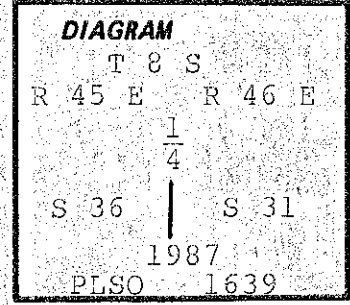

Description of corner evidence found:

Did not find original stone or mound on steep east slope.

Description of monument and accessories I established to perpetuate the original location of this corner:

At position established by survey midway between adjacent section corners North and South...

Set 2 1/2" aluminum cap on 2" aluminum pipe 25" in ground with 5" projecting out of ground with surrounding rock mound and 6' fence post alongside with sign 54-9 attached. Cap marked as shown in diagram.

There being no trees available within limits, I marked the following bearing objects...A basalt boulder 40 x 32 x 26" brs N59°W, 38.6' dist mkd "BXO" on its South top center. A basalt boulder 46 x 28 x 24" brs S27 1/2°E, 65.8' dist mkd "BXO" on its South top center. Each bearing object is painted red.

Compass declination 19° East.

I hereby certify that the above described corner monument was properly re-established by me and witnessed by Jim DeMastus on June 8, 1987.

REGISTERED
PROFESSIONAL
LAND SURVEYOR

William L. Hanley

OREGON
JULY 14, 1978
WILLIAM L. HANLEY
1639

Office of.....County Surveyor.....County of Baker.....
Oregon

State of....., I hereby certify that the within instrument was filed in this office for record on the..... day of....., 19.....

..... by
(COUNTY OFFICIAL) (DEPUTY)