

CERTIFIED RECORD OF LAND CORNER MONUMENTATION

History of Original corner establishment:

**DIAGRAM
BAKER COUNTY
SURVEYOR
T8S R45E
1/4
S2 S1
1997**

The original corner was set by W.B. Barr as part of a subdivisional survey of T. 8 S. R. 45 E., W.M., under GLO contract no. 355, dated June 14, 1880.

The original notes state: Marked basalt rock 24"x12"x12" for 1/4 sec. corner, raised mound of rock as per instructions.

Description of corner evidence found:

No evidence of the original GLO corner was found. Baker County Survey No. 8-45-66 (certified record of land corner monumentation) by Duane Fehringer states: Set 30" long aluminum pipe with 3/4" aluminum cap for the corner. Also a bearing tree was established to reference said corner during the same survey.

No evidence of the aluminum monument was found, the bearing tree (dead) was located and matched very nearly with record bearing and distance to the calculated position as determined by survey. The property owner said that the aluminum monument had been destroyed and removed by farming.

(Also see CS #8-45-61)

Description of monument and accessories I established to perpetuate the original location of the corner:

At the calculated position as detailed by Baker County survey no. 8-45-140, set a 1 1/4"x30" galv. pipe with a 2 1/2" dia. brass cap 2" below ground surface. The brass cap is marked as shown in the corner diagram.


Corner monument references: Four 1"x2 1/2" magnets encased in plastic were set 6" below the ground surface. From the corner monument:

- A silver magnet mkd. "1" bears N. 54° 26' E., 19.8 ft. dist.
- A pink magnet mkd. "2" bears S. 46° 28' E., 22.9 ft. dist.
- A blue magnet mkd. "3" bears S. 44° 09' W., 26.0 ft. dist.
- A orange magnet mkd. "4" bears N. 47° 14' W., 21.5 ft. dist.

Reference bearing and survey: CS 8-45-140

I James D. Hanley certify that this corner was remonumented properly as witnessed by Larry McBroom and Eric Striker on August 14, 1997.

FILED OCT. 29, 1997
BAKER COUNTY SURVEYOR
SURVEY NO. 8-45-140

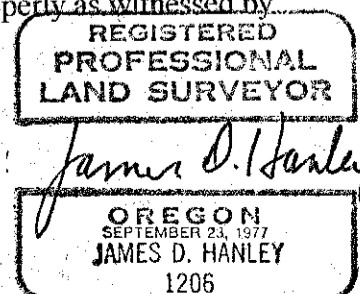

Renews June 30, 1999

10-29-97