

**52 cor. of secs. 1, 6, 31 and 36, T7S and T8S, R44E and R45E**


**HISTORY OF ORIGINAL CORNER ESTABLISHMENT:**

Original corner set by N. O. Walden, under GLO Contract No. 198, approved June 1, 1874.  
Record states: Set basalt rock 12x8x6, 8 in. in ground, and mound of rocks for corner T. 7 & 8 S of R 44, 45 E.  
**Subsequent Monumetation:**  
Corner rehabilitated by W. B. Barr, under GLO Contract No. 503, approved March 21, 1885.  
Record states: A basalt rock 12x8x6 ins., firmly planted in the ground marked with 6 notches on the N, S, E, and W edges.  
Corner remonumented Lester E. Fischer, under BLM Group No. 350, approved June 13, 1877.

Record States: The cor. of Tps. 7 and 8 S., R's. 44 and 45 E., monumented with the original basalt stone, 12x8x6 ins., firmly set 10 ins. in the ground, and in a mound of stone, 2 ft. base, 6 ins. high, mkd. with 6 grooves on S., W., and N. faces. At the corner point: Set an iron post, 28 ins. long, 2½ ins. diam., 18 ins. in the ground, to bedrock, and in a mound of stone, 2½ ft. base, to top, with brass cap mkd. (as shown below), from which:

A ponderosa pine, 10 ins. diam., bears S. 84°W., 354 lbs. dist., mkd. T8S R44E S1 BT.  
A ponderosa pine, 15 ins. diam., bears N. 45°W., 274 lbs. dist., mkd. T7S R44E S36 BT.

Bury corner stone alongside iron post. No other suitable trees available within limits.

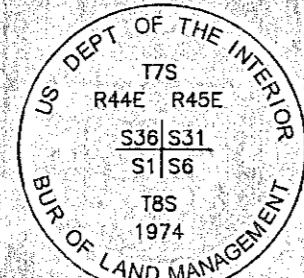

**DESCRIPTION OF CORNER EVIDENCE FOUND:**

Found an iron pipe 2½ ins. diam., projecting 6 ins. above ground, with rock collar and 3¼ ins. diam. brass cap mkd. as shown.

From the recovered monument I find the Fischer bearing tree/remains:

Pine stump remains, bears S. 84°W., 354 lbs. dist., with scribe T8S R44E S1 BT.

A ponderosa pine, 30 ins. diam., alive and healthy, bears N. 45°W., 274 lbs. dist., with healed blaze.

Found guard post 2½ ft. N'ly of monument.

**DESCRIPTION OF MONUMENT AND ACCESSORIES ESTABLISHED TO PERPETUATE LOCATION OF THIS CORNER:**

New accessories:  
A silver DEEP-1 magnet, buried 10 ins. in ground, bears N. 45° E., 12.3 ft. dist.  
A pink DEEP-1 magnet, buried 10 ins. in ground, bears S. 37° E., 13.7 ft. dist.  
A 5/8 ins. diam. by 30 ins. long rebar, 28 ins. in the ground, bears S. 45° W., 15.0 ft. dist., with 1½ ins. diam. alum cap mkd. RM1 2013 LS-2648  
A 5/8 ins. diam. by 30 ins. long rebar, 28 ins. in the ground, bears N. 45° W., 15.0 ft. dist., with 1½ ins. diam. alum cap mkd. RM2 2013 LS-2648

Added Land Survey Monument (54-9) sign to guard post.

Auto C/A geographic position.

Lat. 44°54'23.1" N

Long. 117°16'00.1" W

Witnesses: Ron Walter and Brenda Johnson

**53 1/4 cor. of secs. 31, and 36, T7S, R44E and R45E**

**HISTORY OF ORIGINAL CORNER ESTABLISHMENT:**

Original corner set by W. B. Barr, under GLO Contract No. 503, approved March 21, 1885.

Record States: Set volcanic rock 16x8x8 ins. 11 inches in ground for 1/4 sec. corner marked ¼ on the West side, from which:

A pine 8 ins. diam. bears S25°E, 118 lbs. dist. marked 1/4SBT.

A pine 34 ins. diam. bears S60°W, 65 lbs. dist. marked 1/4SBT.

**Subsequent Monumetation:**

Corner remonumented by Lester E. Fischer, under BLM Group No. 350, approved June 13, 1977.

Record States: The ¼ sec. cor. of secs 31 and 36, on the E. bdy. of the Tp., monumented with the original basalt stone 16x8x8 ins., firmly set 4 ins. in the ground, mkd. ¼ on W. face, from which the remains of the original bearing trees. A root hole, bears S. 25° E., 118 lbs. dist. with a down and decayed ponderosa pine alongside, 10 ins. diam., with scribe marks ¼, S BT visible on open double blaze.

A root hole, bears S. 60° W., 65 lbs. dist. with a down and decayed ponderosa pine alongside, 34 ins. diam., no marks visible.

At the corner point: Set an iron post, 28 ins. long, 2½ ins. diam., 20 ins. in the ground, to bedrock, and in a mound of stone, 1 ft. base, to top, with brass cap mkd. (as shown below). From which new bearing trees:

A ponderosa pine, 10 ins. diam., bears S. 72° E., 61½ lbs. dist., mkd 1/4 S31 BT.

A ponderosa pine, 12 ins. diam., bears N. 12° W., 41 lbs. dist., mkd 1/4 S36 BT.

Bury corner stone alongside iron post.

**DESCRIPTION OF CORNER EVIDENCE FOUND:**

Found iron pipe 2½ ins. diam., firmly set, projecting 6 ins. above ground, with rock collar, and 3¼ ins. diam. brass cap mkd. as shown.

From the recovered monument I find the original bearing tree remains:

A root hole, bears S. 25° E., 118 lbs. dist., with scattered remains and illegible scribing.

Pine remains, bears S. 60° W., 65 lbs. dist.

And accessories mkd. by Fischer.

A ponderosa pine, dead and down, 10 ins. diam., bears S. 25° E., 118 lbs. dist., with illegible scribe visible on partially open blaze.

A ponderosa pine, 15 ins. diam., alive and healthy, bears N. 12° W., 26.6 ft. dist., with healed blaze. (BLM, 41 lbs.)

Found guard post 6 ft. S'ly of monument, with Attention (54-4) sign.

**DESCRIPTION OF MONUMENT AND ACCESSORIES ESTABLISHED TO PERPETUATE LOCATION OF THIS CORNER:**


New accessories:  
A ponderosa pine, 16 ins. diam., bears N. 35°W., 80.9 ft. dist., mkd. 1/4 S31 BT.  
A Douglas fir, 7 ins. diam., bears S. 5° E., 63.9 ft. dist., mkd. X BT.  
A blue DEEP-1 magnet, buried 10 ins. in ground, bears S. 64°W., 118 ft. dist.

Auto C/A geographic position.

Lat. 44°54'49.7" N

Long. 117°15'59.5" W

Witnesses: Ron Walter and Brenda Johnson

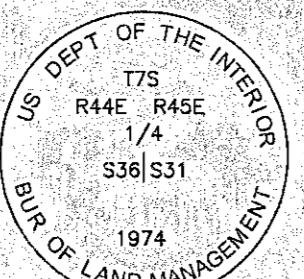

**54 cor. of secs. 25, 30, 31 and 36, T7S and T8S, R44E and R45E**

**HISTORY OF ORIGINAL CORNER ESTABLISHMENT:**

Original corner set by W. B. Barr, under GLO Contract No. 443, approved March 13, 1883.

Record states: Set a basalt rock 14x12x9 ins. 11 inches in ground for corner to secs 25, 30, 31, 36 marked with 1 notch on the S and 5 notches on the N side from which:  
A Pine 20 in. diam. bears N 54° E 50 lbs. dist. marked T7S R44E S30 BT.  
A Pine 24 in. diam. bears N 57° W 120 lbs. dist. marked T7S R44E S25 BT.  
A Pine 15 in. diam. bears S 60° W 200 lbs. dist. marked T7S R44E S36 BT.  
A Pine 22 in. diam. bears S 36° E 270 lbs. dist. marked T7S R44E S31 BT.

**Subsequent Monumetation:**

Corner rehabilitated by W. B. Barr, under GLO Contract No. 503, approved March 21, 1885.

Record states: A basalt rock 14x12x9 ins. planted firmly in the ground marked with 1 notch on the South and 5 notches on the North edges from which:

A Pine 20 in. diam. bears N 54° E 50 lbs. dist. marked T7S R44E S30 BT.  
A Pine 24 in. diam. bears N 57° W 120 lbs. dist. marked T7S R44E S25 BT.  
A Pine 15 in. diam. bears S 60° W 200 lbs. dist. marked T7S R44E S36 BT.  
A Pine 22 in. diam. bears S 36° E 270 lbs. dist. marked T7S R44E S31 BT.

Corner remonumented by Lester E. Fischer, under BLM Group No. 350, approved June 13, 1977.

Record States: The cor. of secs. 25, 30, 31, and 36, on the E. bdy. of the Tp., monumented with the original basalt stone, 14x12x9 ins., firmly set 4 ins. in the ground, mkd. with 5 notches on N. edge and 1 groove on S. face, from which the remains of the original bearing trees:

A ponderosa pine, 34 ins. diam., bears N. 57° E., 70 lbs. dist., with scribe mark S visible on opened blaze. (Record, N. 54° E., 50 lbs.)

A decayed ponderosa pine stump, 30 ins. diam., bears S. 27° E., 270 lbs. dist., with a down and decayed ponderosa pine alongside, 30 ins. diam., with scribe marks T7S R44E S31 BT visible on open double blaze. (Record, S. 36° E.)

A ponderosa pine snag, 24 ins. diam., bears S. 62° W., 200 lbs. dist., with scribe marks S E BT visible on open double blaze. (Record, S. 60° W.)

A ponderosa pine, 40 ins. diam., bears N. 57° W., 120 lbs. dist., with illegible scribe marks visible on partially healed double blaze.

At the corner point Set an iron post, 28 ins. long, 2½ ins. diam., 16 ins. in the ground, to bedrock, and in a mound of stone, 2 ft. base, to top, with brass cap mkd. (as shown below). From which new bearing trees:

From new bearing trees:  
A ponderosa pine, 10 ins. diam., bears S. 63° E., 41 lbs. dist., mkd. T7S R44E S31 BT.

A ponderosa pine, 12 ins. diam., bears S. 27° W., 19 lbs. dist., mkd. T7S R44E S36 BT.

A ponderosa pine, 9 ins. diam., bears N. 63° W., 18 lbs. dist., mkd. T7S R44E S25 BT.

Bury corner stone alongside iron post.

**DESCRIPTION OF CORNER EVIDENCE FOUND:**

Found an iron pipe 2½ ins. diam., projecting 12 ins. above ground, with 3 ft. diam. mound of stone to top, and 3¼ ins. diam. brass cap mkd. as shown.

From the recovered monument I find the original bearing tree remains:

A ponderosa pine, dead and down, bears N. 57° E., 70 lbs. dist., with scribe marks visible on opened blaze.

Decayed ponderosa pine stump remains, bears S. 27° E., 270 lbs. dist.

A ponderosa pine stump, bears S. 62° W., 200 lbs. dist., with partial scribe visible on open double blaze.

A ponderosa pine snag, bears N. 57° W., 120 lbs. dist., with illegible scribe marks visible on partially healed blaze.

And accessories mkd. by Fischer:  
A ponderosa pine, dead and down, bears S. 63° E., 41 lbs. dist., with scribe marks visible on partially open blaze.

A ponderosa pine, 13ins. diam., alive and healthy, bears S. 27° W., 19 lbs. dist., with scribe marks visible on partially open blaze.

A ponderosa pine, dead and down, bears N. 63° W., 18 lbs. dist., with decayed stump and scribe marks T7S R44E S25 BT visible on a piece of stump.

Found guard post 5 ft S'ly of monument.

**DESCRIPTION OF MONUMENT AND ACCESSORIES ESTABLISHED TO PERPETUATE LOCATION OF THIS CORNER:**

New bearing trees:

A ponderosa pine 19 ins. diam., bears S. 42° E., 85.1 ft. dist., mkd. T7S R44E S31 BT.

A ponderosa pine, 17 ins. diam., bears S. 79° W., 77.8 ft. dist., mkd X BT on a double blaze, same quadrant as existing Fischer bearing tree.

A ponderosa pine, 11 ins. diam., bears N. 69° W., 84.7 ft. dist., mkd. T7S R44E S25 BT.

No suitable trees in NE quadrant.

Auto C/A geographic position:

Lat. 44°55'15.4" N

Long. 117°15'58.9" W

Witnesses: Ron Walter and Brenda Johnson

**55 1/4 cor. of secs. 25 and 30, T7S, R44E and R45E**

**HISTORY OF ORIGINAL CORNER ESTABLISHMENT:**

Original corner set by W. B. Barr, under GLO Contract No. 443, approved March 13, 1883.

Record states: Set a boulder rock 12x8x8 ins. 8 inches in ground for 1/4 sec. corner marked ¼ on the West side, from which:

A fir 3 ins. diam. bears S61°E, 4 lbs. dist. marked 1/4SBT.

A fir 3 ins. diam. bears S48°W, 5 lbs. dist. marked 1/4SBT.

**Subsequent Monumetation:**

Corner remonumented by James H. Hambleton, LS 645, as described by Survey No. 7-45-41, filed September, 26, 1978, in the records of the Baker County Surveyor.

Record States: Made extensive search in area determined creek had flooded the area possibly by cloud burst; found no trace of corner stone nor the bearing trees.

After careful search, I determined his corner to be a lost corner, therefore relocated the corner by single proportionate measurements of which I set a 24" x 30" galv. iron pipe w/ brass cap stamped as shown (below), in the ground and placed a large mound of stone and dirt around the monument.

New bearing trees:  
6' fir bears N68°W, 47.42 ft. scribed 1/4 S25 BT.  
10' fir bears South, 37.08 ft. scribed 1/4 S30 BT.

**continues in next column:**

**continued from previous column:**

**DESCRIPTION OF CORNER EVIDENCE FOUND:**

Found iron pipe 2½ ins. diam., firmly set, flush with ground, with rock collar 4 ins. above cap, and 2½ ins. diam. brass cap, MISMARKED as shown:

From the recovered monument I find the Hambleton bearing trees:

A white fir, 16 ins.