


T. 8 S., R. 46 E., W.M.

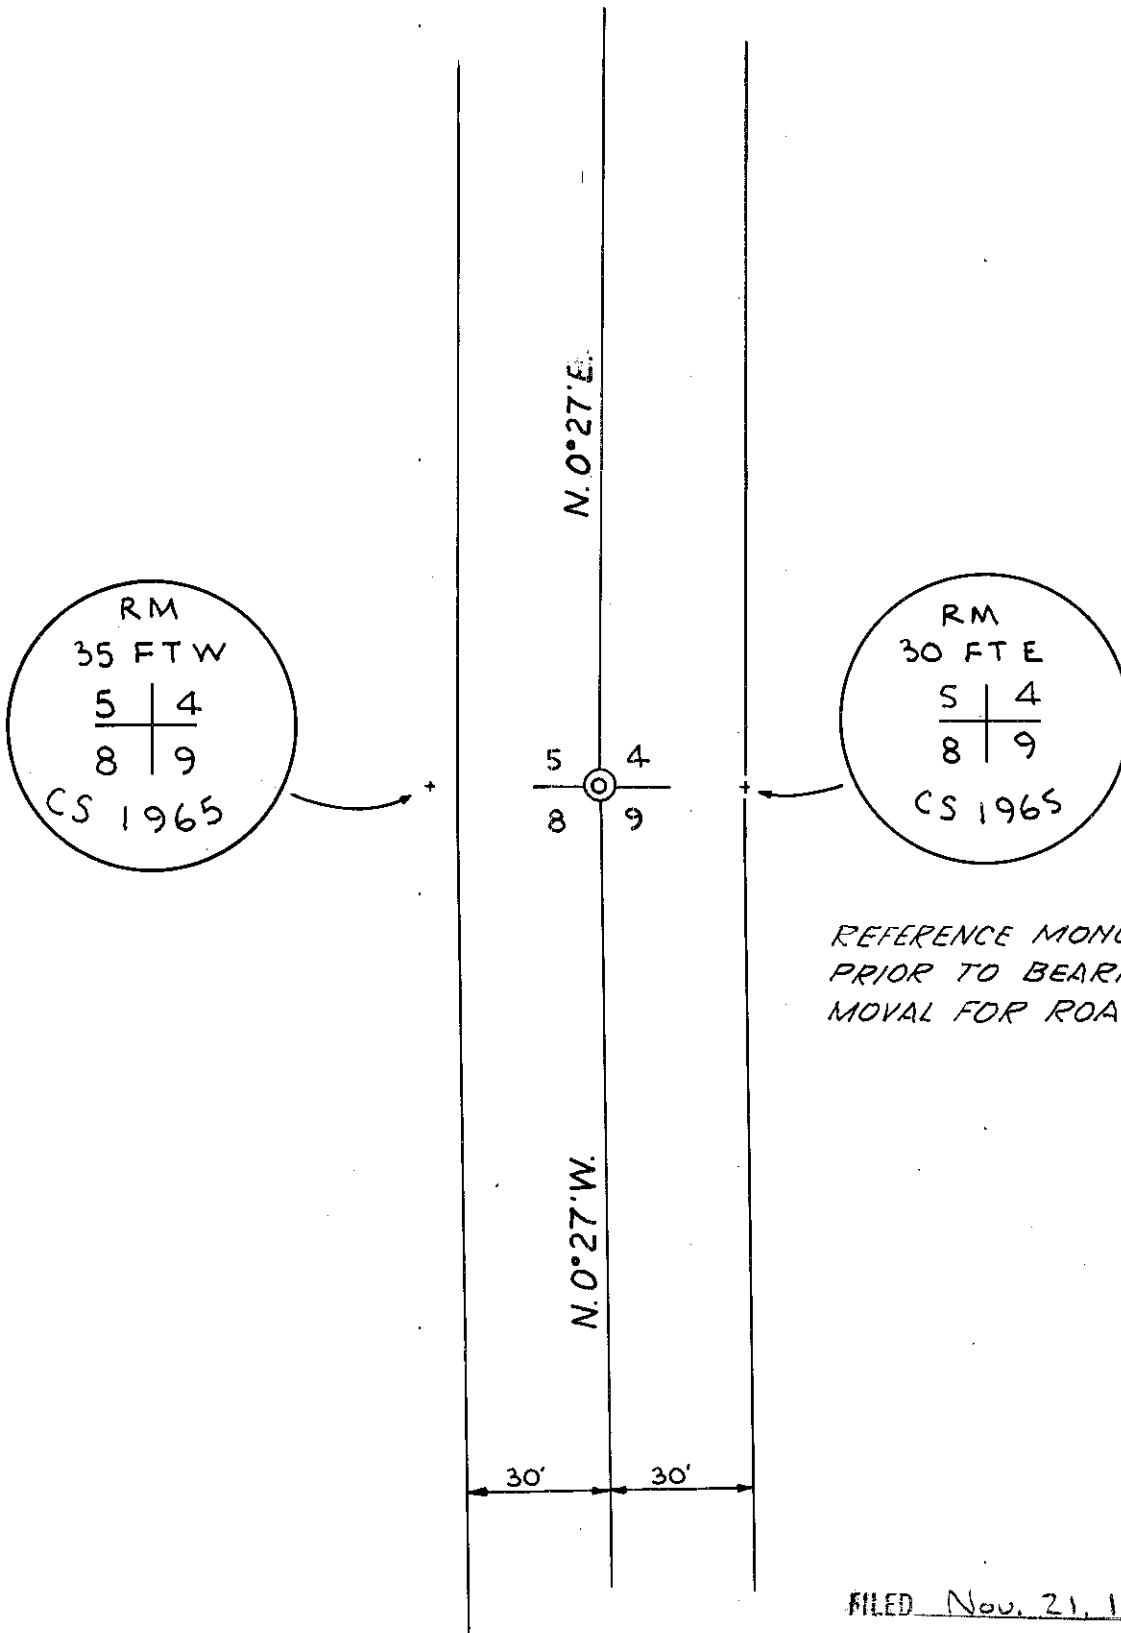

REFERENCE MONUMENTS SET  
PRIOR TO BEARING TREE RE-  
MOVAL FOR ROAD WIDENING.

FILED Nov. 21, 1965

BAKER COUNTY SURVEYOR

SURVEY NO. B-46-5