The original corners common to Secs. 8 and 17 have been obliterated. The points indicated hereon as corners represent the location of the corners as near as could be determined, to the best of the undersigneds' ability.

Since the legal descriptions of properties involved in this survey are based on direction of Main Street being N. 22°45'W. and S. 22°45'E., all courses of this survey are based and are referred to a Meridian from which Main Street bears N. 22°45'W. and S. 22°45'E. Attempt was made to determine distances to nearest tenth of a foot, in calculating closures and making measurements on ground.

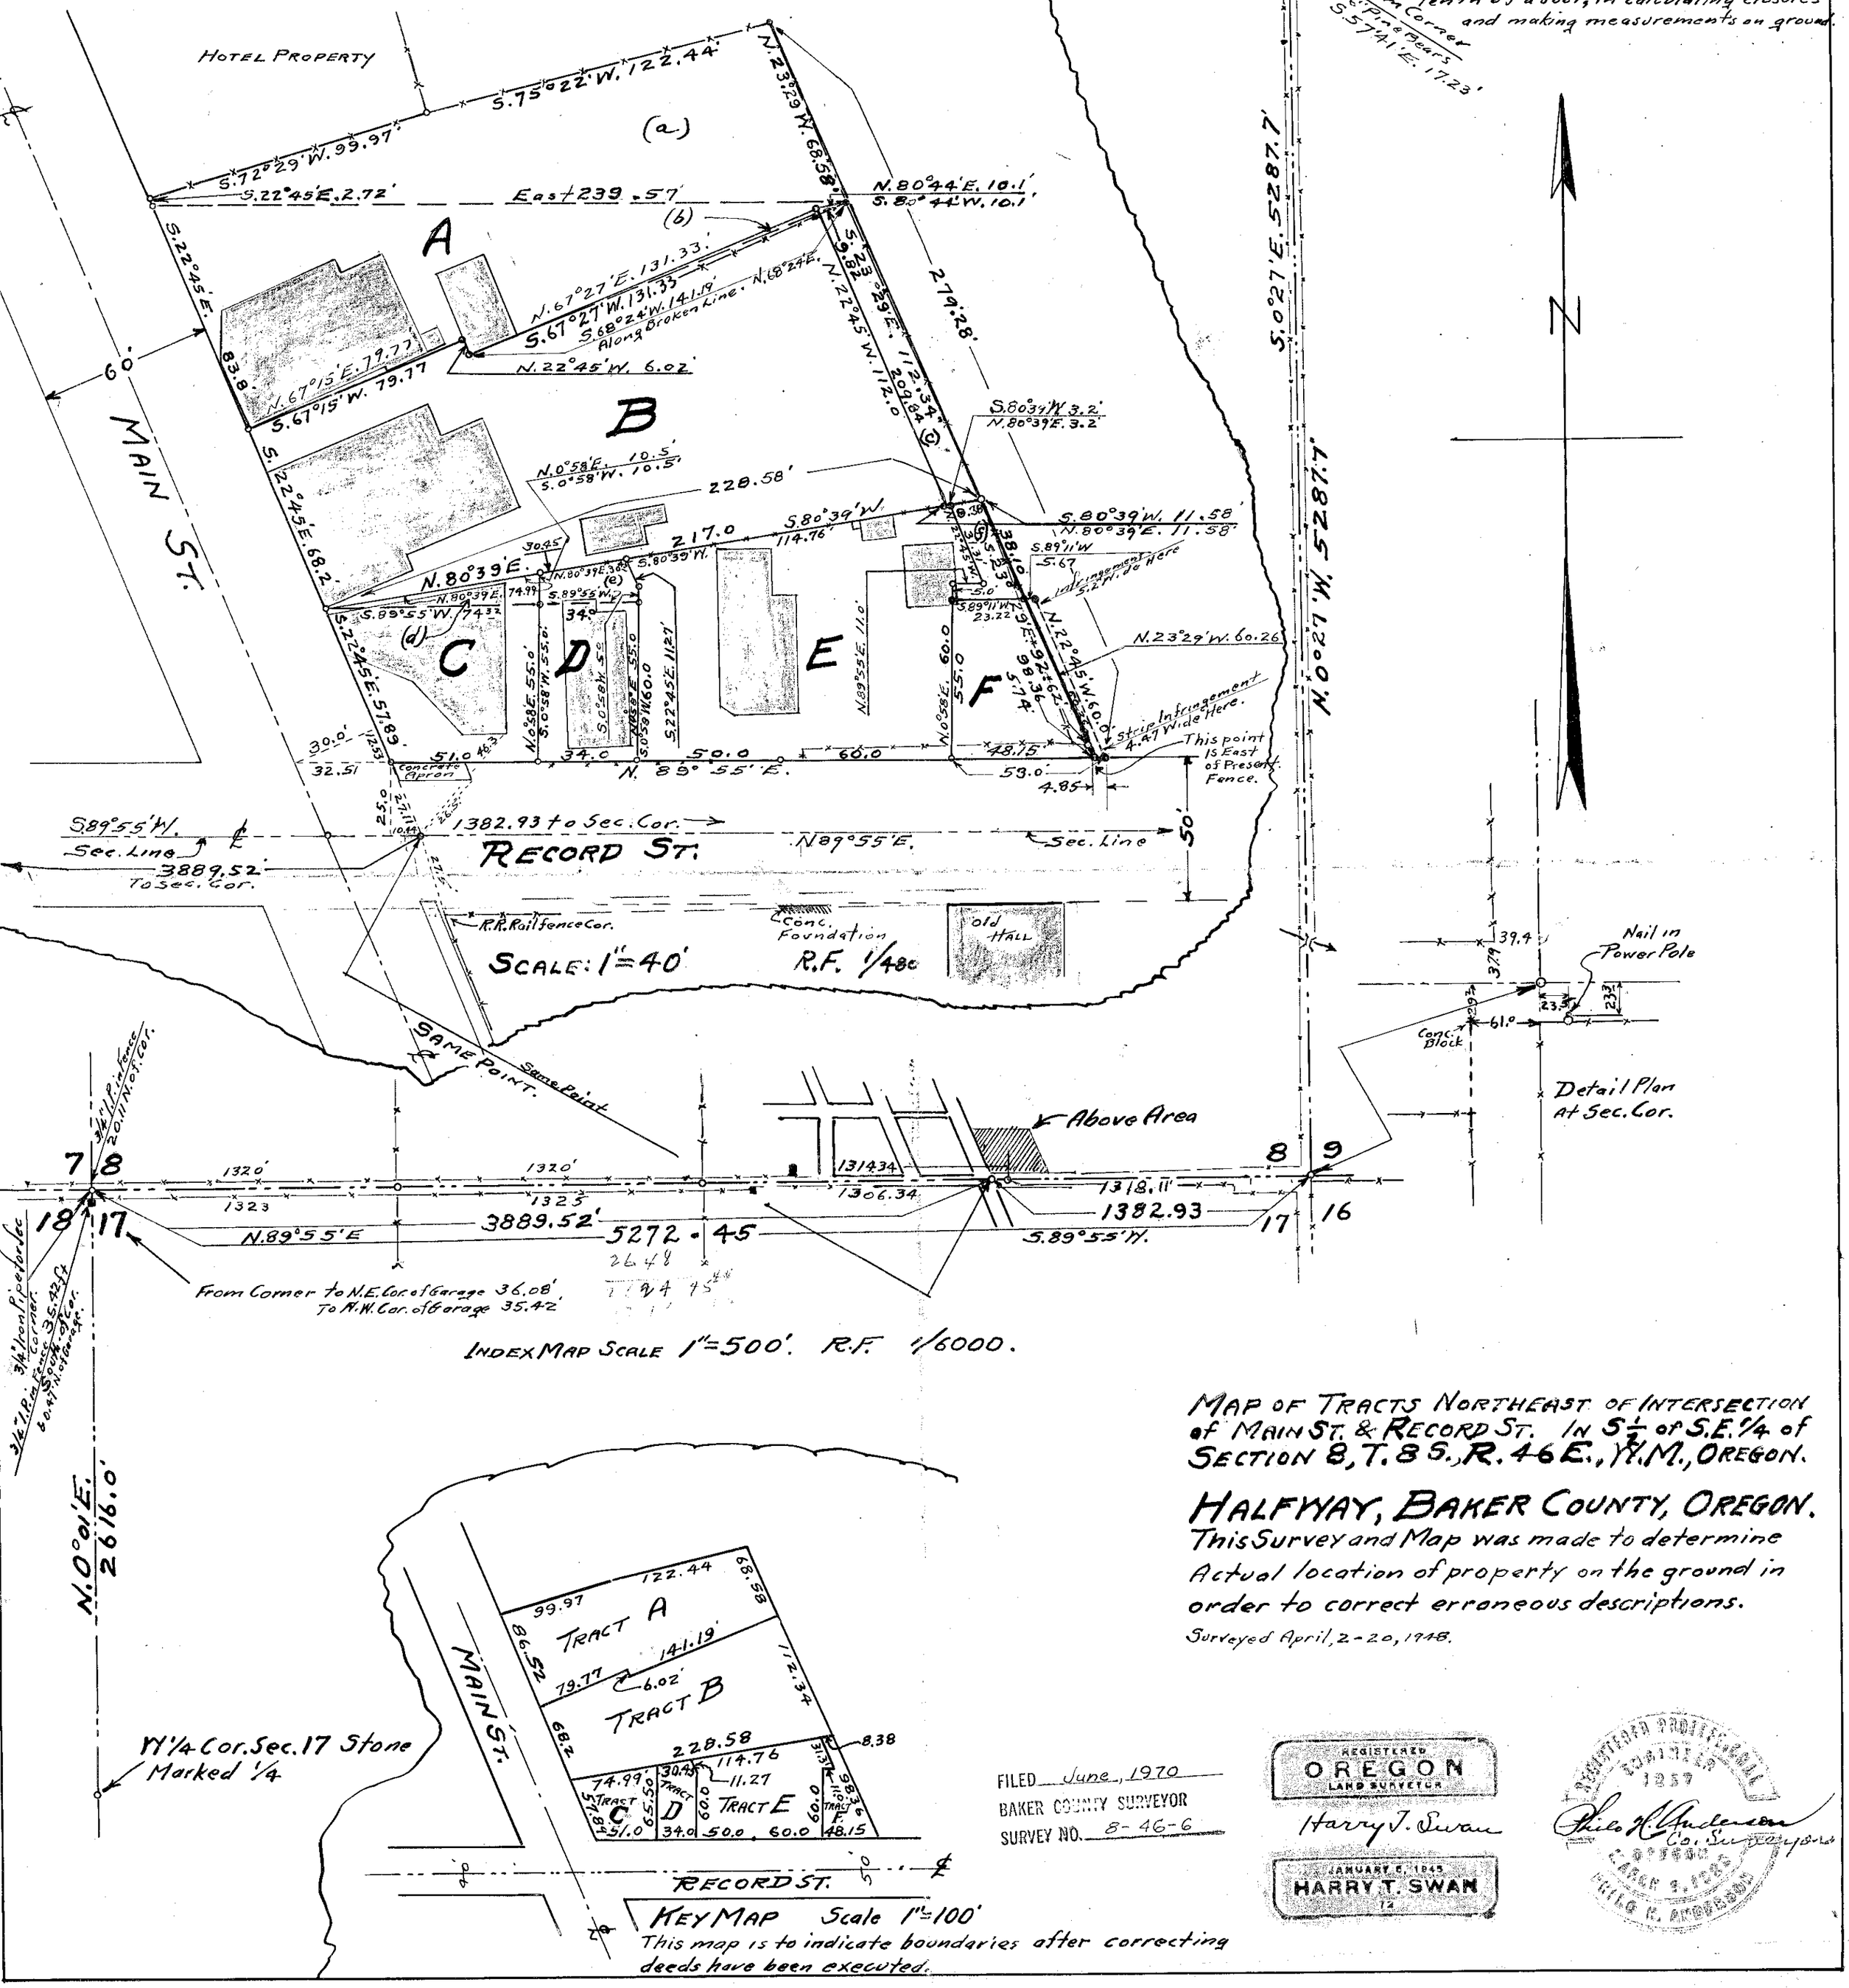

INDEX MAP SCALE 1"=500'. R.F. 1/6000.

N. 0° 01' E. 2616.0'

W 1/4 Cor. Sec. 17 Stone Marked 1/4

KEY MAP Scale 1"=100'

This map is to indicate boundaries after correcting deeds have been executed.

MAP OF TRACTS NORTHEAST OF INTERSECTION of MAIN ST. & RECORD ST. IN S½ of S.E.¼ of SECTION 8, T. 8 S., R. 46 E., W.M., OREGON.

HALFWAY, BAKER COUNTY, OREGON.

This Survey and Map was made to determine Actual location of property on the ground in order to correct erroneous descriptions.

Surveyed April, 2-20, 1948.

FILED June, 1970
BAKER COUNTY SURVEYOR
SURVEY NO. 8-46-6

REGISTERED OREGON LAND SURVEYOR
Harry T. Swan
JANUARY 6, 1965
HARRY T. SWAN
74

REGISTERED PROFESSIONAL ENGINEER
1257
Philo K. Anderson
Co. Surveyor
OREGON
MARCH 3, 1952
PHILO K. ANDERSON