


CERTIFIED RECORD OF LAND CORNER MONUMENTATION

History of original corner establishment:

Surveyed by N. O Walden under contract No. 198,
July 15, 1873.

He set a basalt stone 12 x 8 x 6 ins. for corner
to Secs. 24, 19, 13, and 18, from which:

A fir 14 ins. diam. bears N 75° W., 40 lks. dist.
A pine 14 ins. diam. bears S 30° E., 150 lks.
dist.

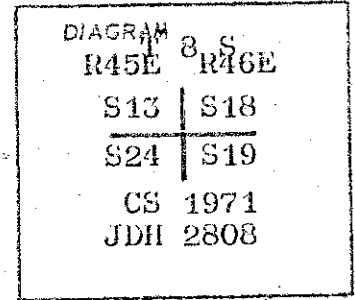

Description of corner evidence found:

Found Sec 19 BT S 30°E, 99 feet from corner location. Scribe had
completely grown over. No marked stone found.

Description of monument and accessories established to perpetuate the
original location of this corner

Set iron post monument with aluminum cap, N 30° W., 99 feet from
found bearing tree, August 7, 1971, marked as shown on diagram above.

Office of County Surveyor County of Baker
State of Oregon, I hereby certify that the within instrument was filed in this office
for record on the 7 day of August, 1971
by Tom Hamley
(COUNTY OFFICIAL) (DEPUTY)

8-46-7 ON HANDS

