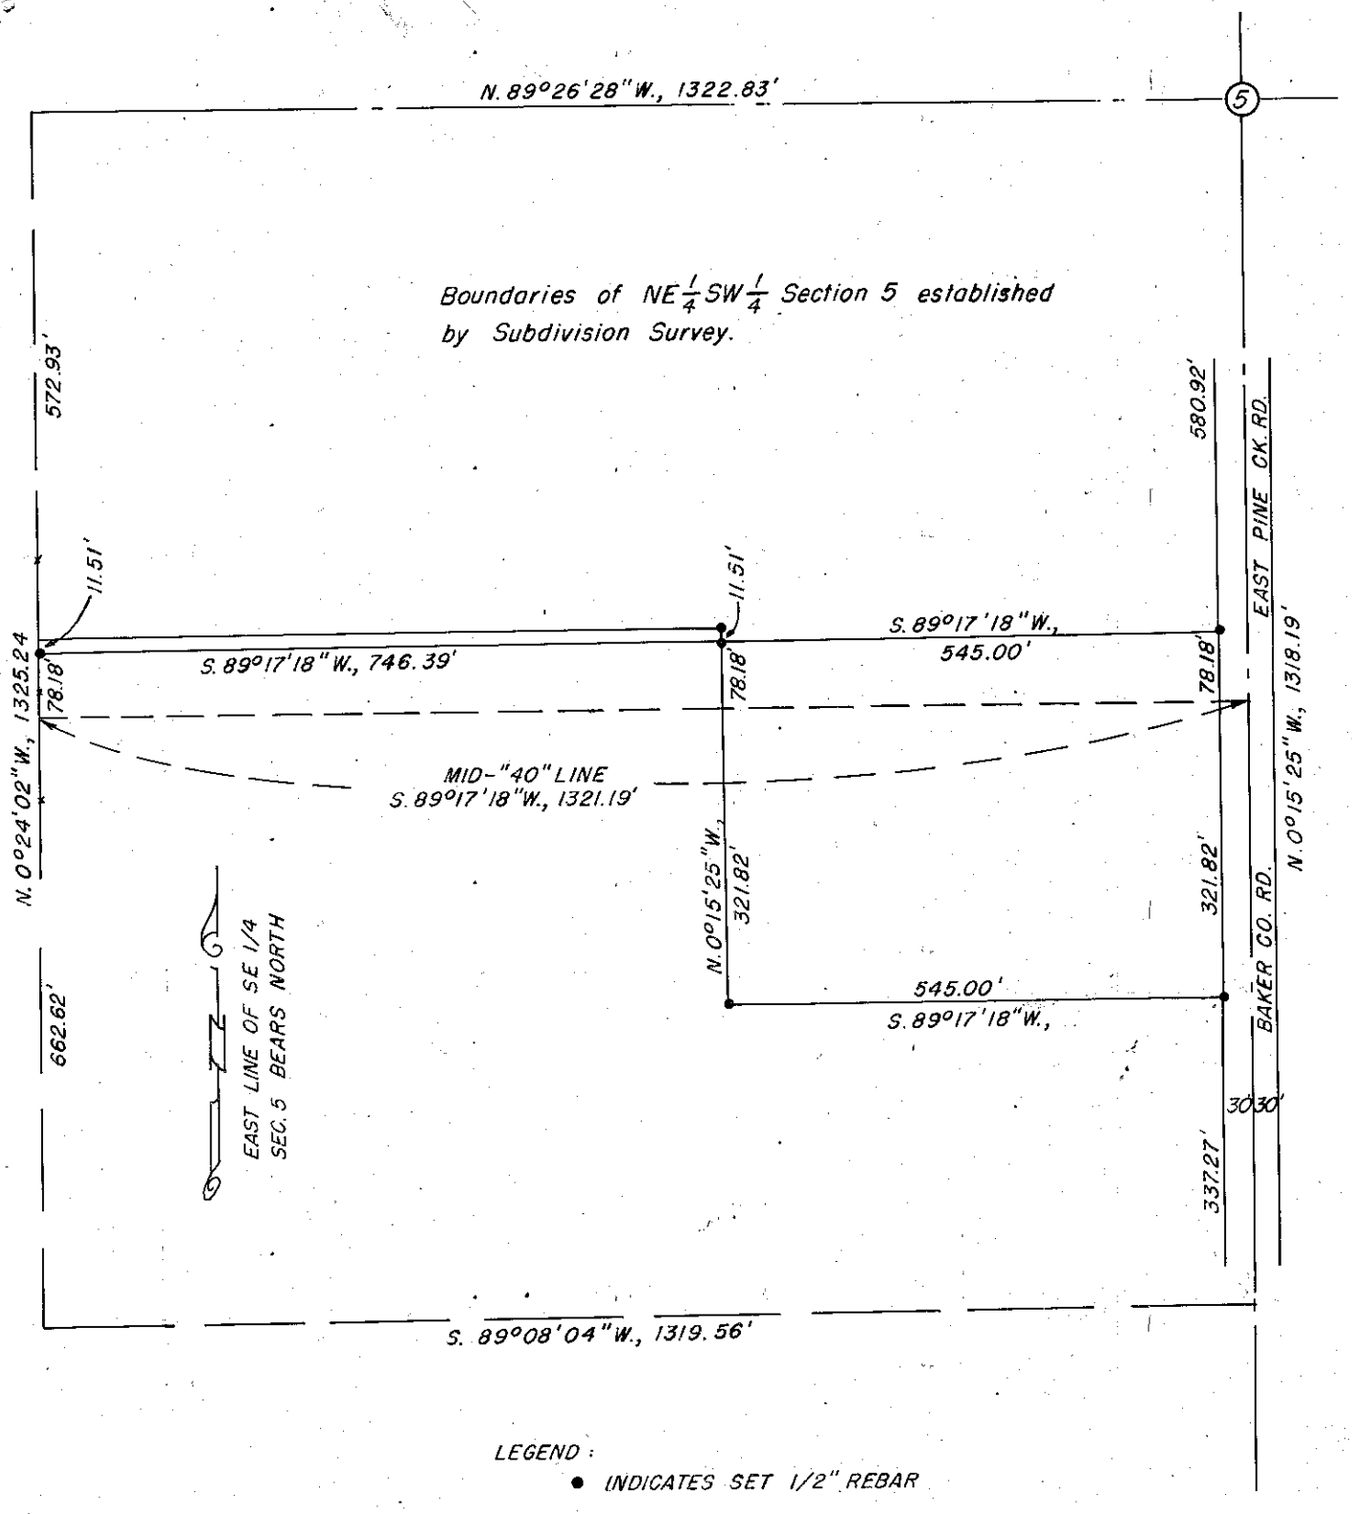

LEGEND :

● INDICATES SET 1/2" REBAR

MAP OF SURVEY

A PARCEL IN THE NE 1/4 SW 1/4 S.5, T.8S., R.46E., W.M.

Surveyed Aug. 19 & 27, and Sept. 19, 1974

Scale 1" = 200'

For M.L. Carter

REGISTERED PROFESSIONAL ENGINEER
2802
James D. Hanley
OREGON
MAY 1, 1948
JAMES D. HANLEY

FILED Oct. 14, 1974
BAKER COUNTY SURVEYOR
SURVEY NO. B-46-17