


Meridian by Solar Observation

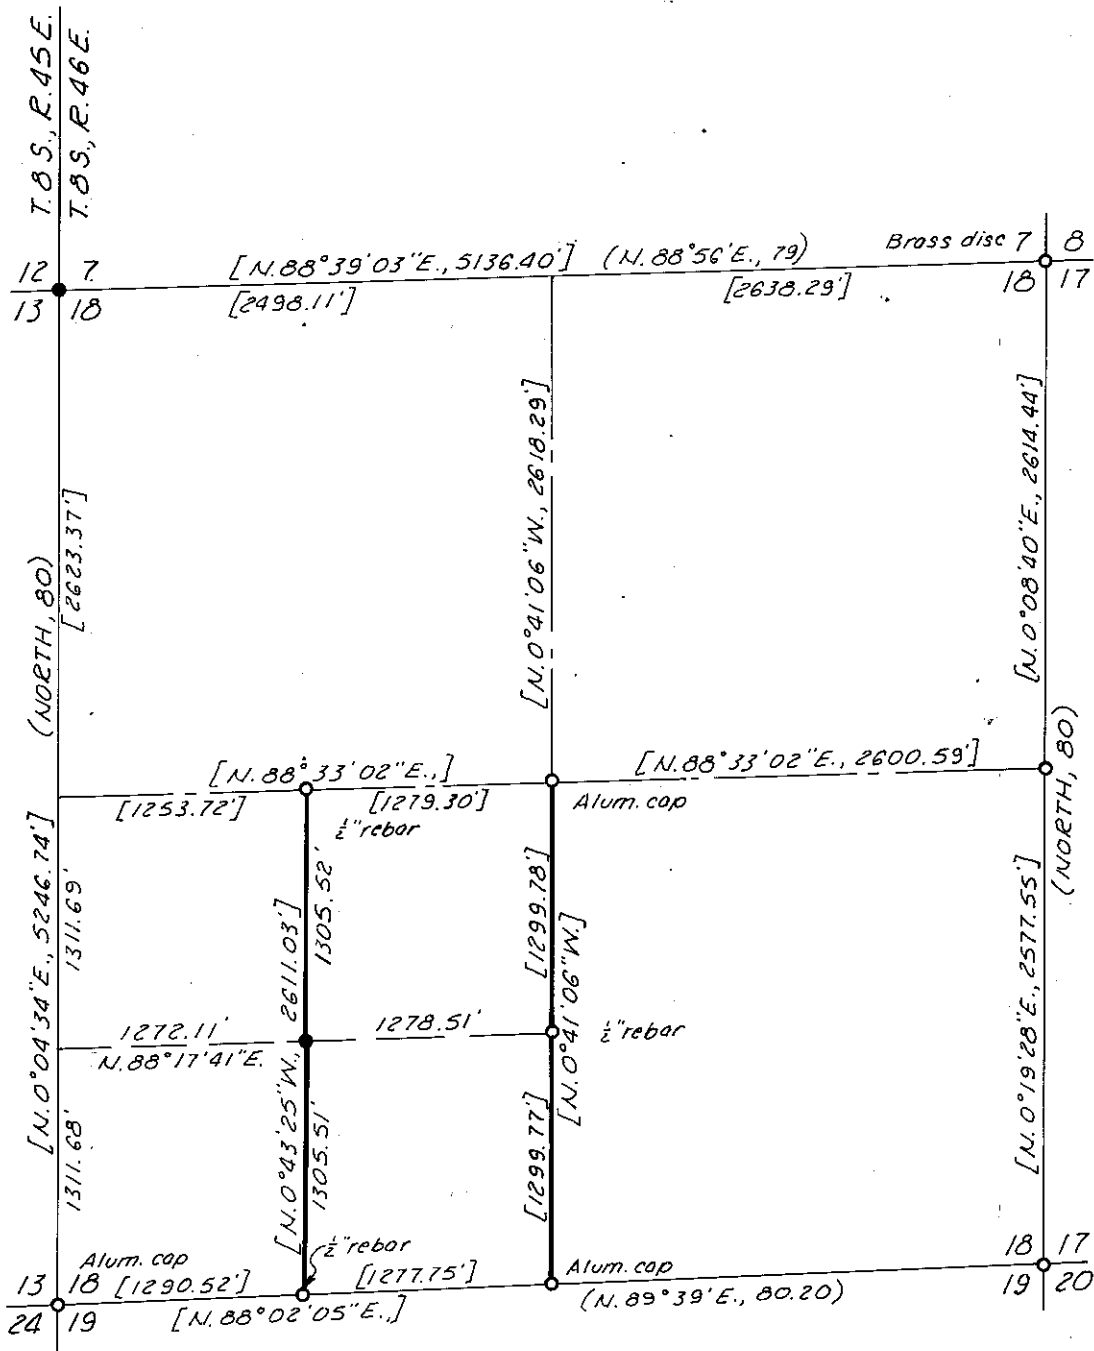

LEGEND

- MONUMENT OF RECORD
- SET 5/8" x 30" REBAR
- [] RECORD OF SURVEY 8-46-18
- () GLO RECORD - ORIG. SURVEY
- LINE MARKED THIS SURVEY

MAP OF SURVEY
IN THE SW 1/4 OF SECTION 18, T.8S., R.46E., W.M.

Surveyed July 14 : 21, 1980 Scale 1"=1000'

FOR LAWRENCE SHELGER

REGISTERED
PROFESSIONAL
LAND SURVEYOR

James D. Hanley
OREGON
SEPTEMBER 23, 1977
JAMES D. HANLEY
1206

FILED Aug. 15, 1980
BAKER COUNTY SURVEYOR
SURVEY NO. 8-46-27