


NARRATIVE


The purpose of this survey for Dick Crow was to mark on the ground two of the corners of the parcel described in Deed 92-24-123. Monuments at Dawson and First and Dawson and Gover Lane were recovered. Basis of bearing given on Survey No. 8-46-29 wherein Dawson Street bears S. 89°55'11"E. is held for this subject survey. Dawson Street is parallel to Record Street.

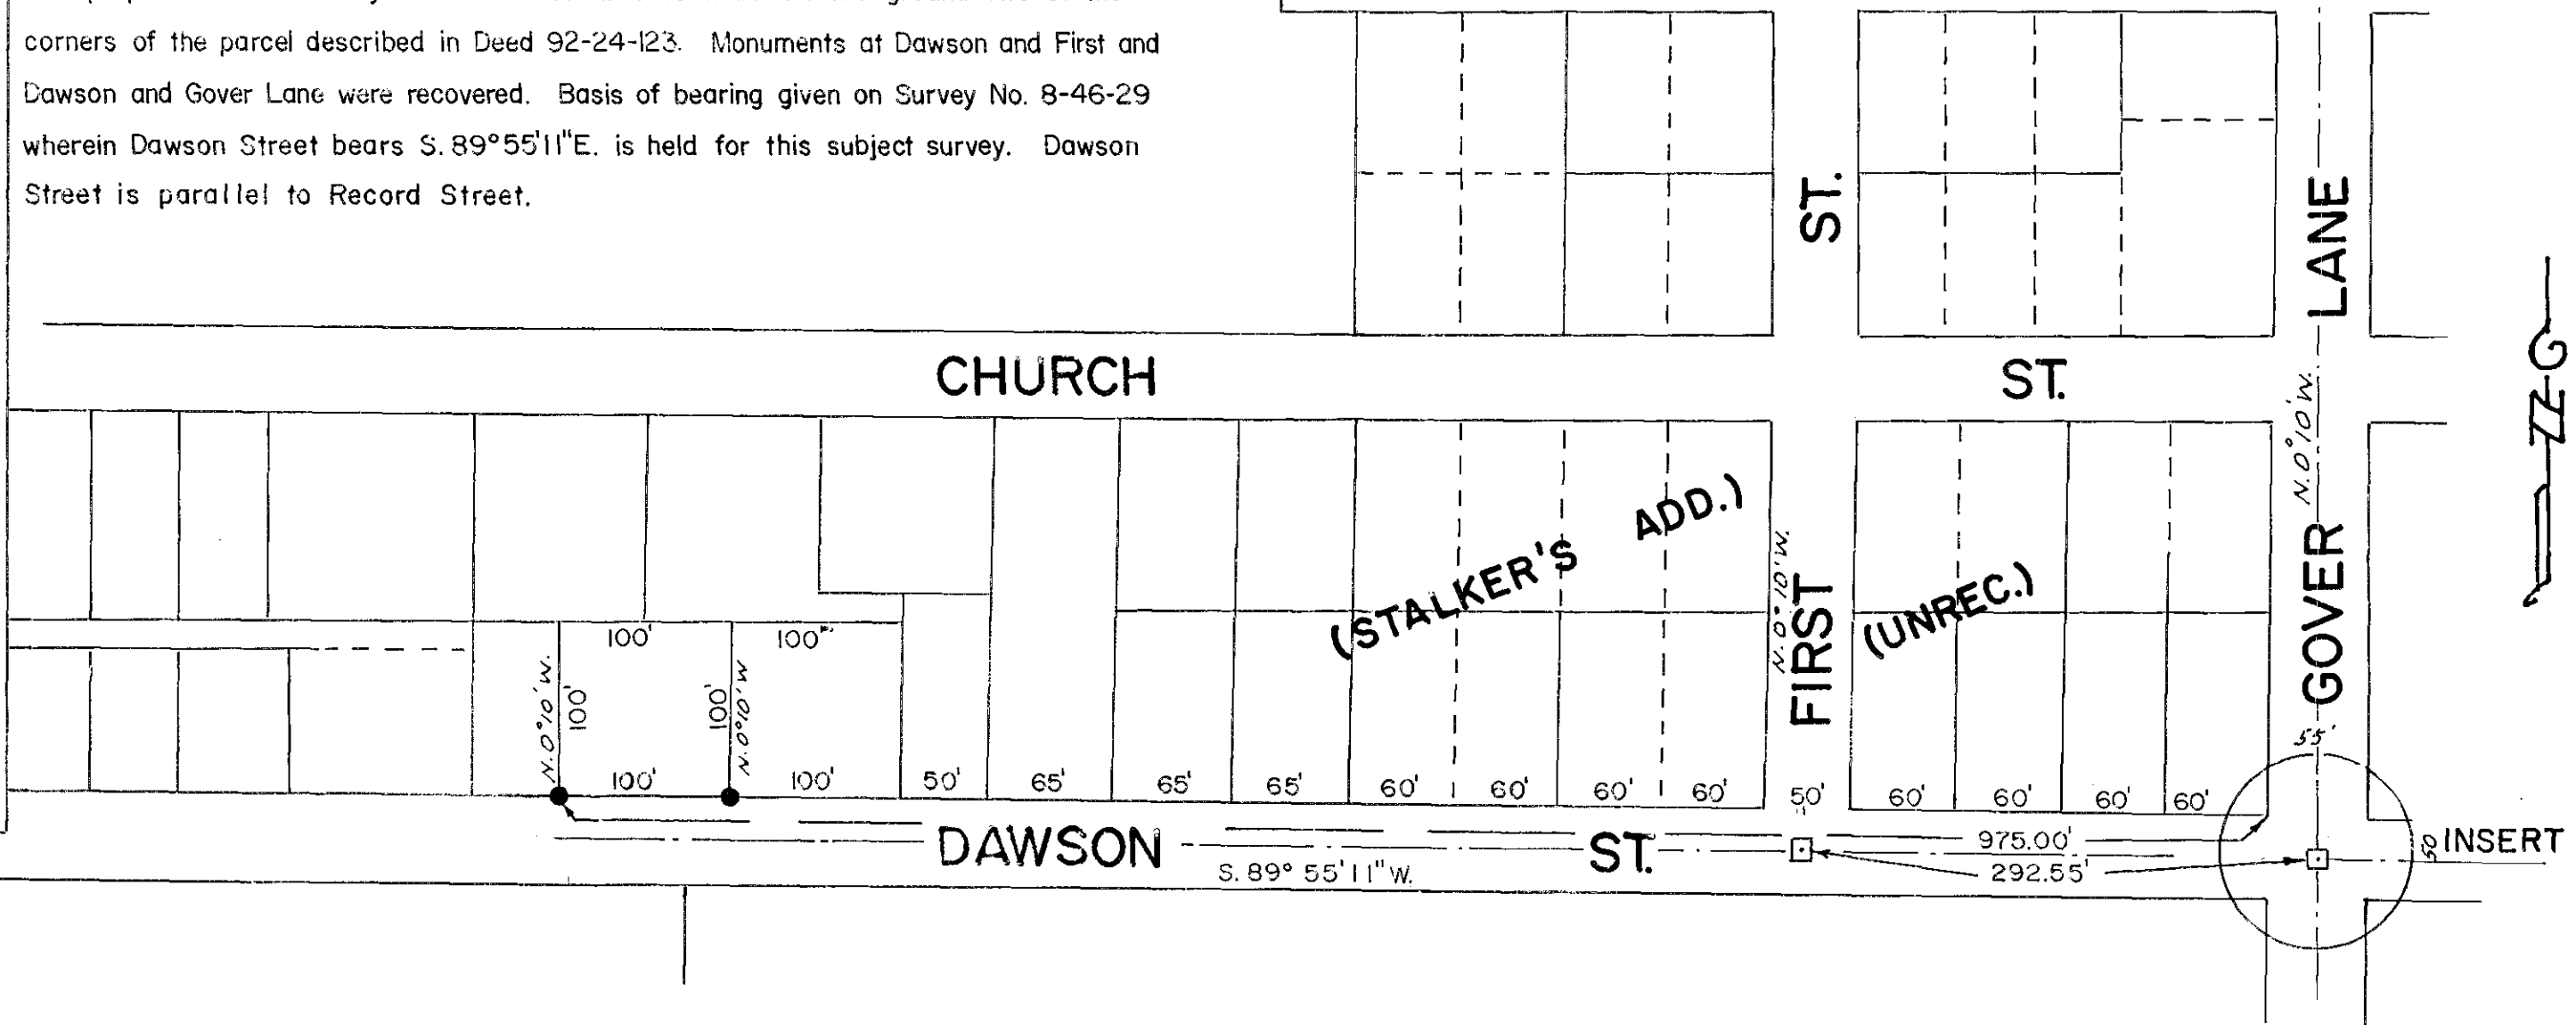

LEGEND

Found iron pin in 3 inch pipe case
 Set 5/8" x 30" rebar with plastic cap mkd "HANLEY ENGRG PLS 1206"

MAP OF SURVEY
 PARCEL IN SEC. 17, T. 8S., R. 46E., WM.
 HALFWAY, OREGON
 Surveyed Oct. 13, 1994 Scale 1" = 100'
 For Dick Crow

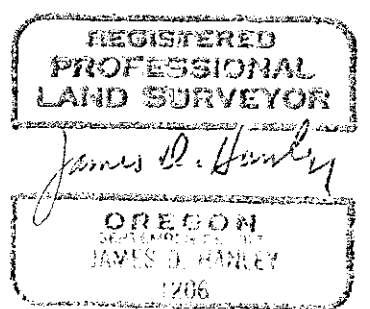

Renewal Date Jan. 1, 1996

FILED 11-1-94
 BAKER COUNTY SURVEYOR
 SURVEY NO. 8-46-61

INSERT

