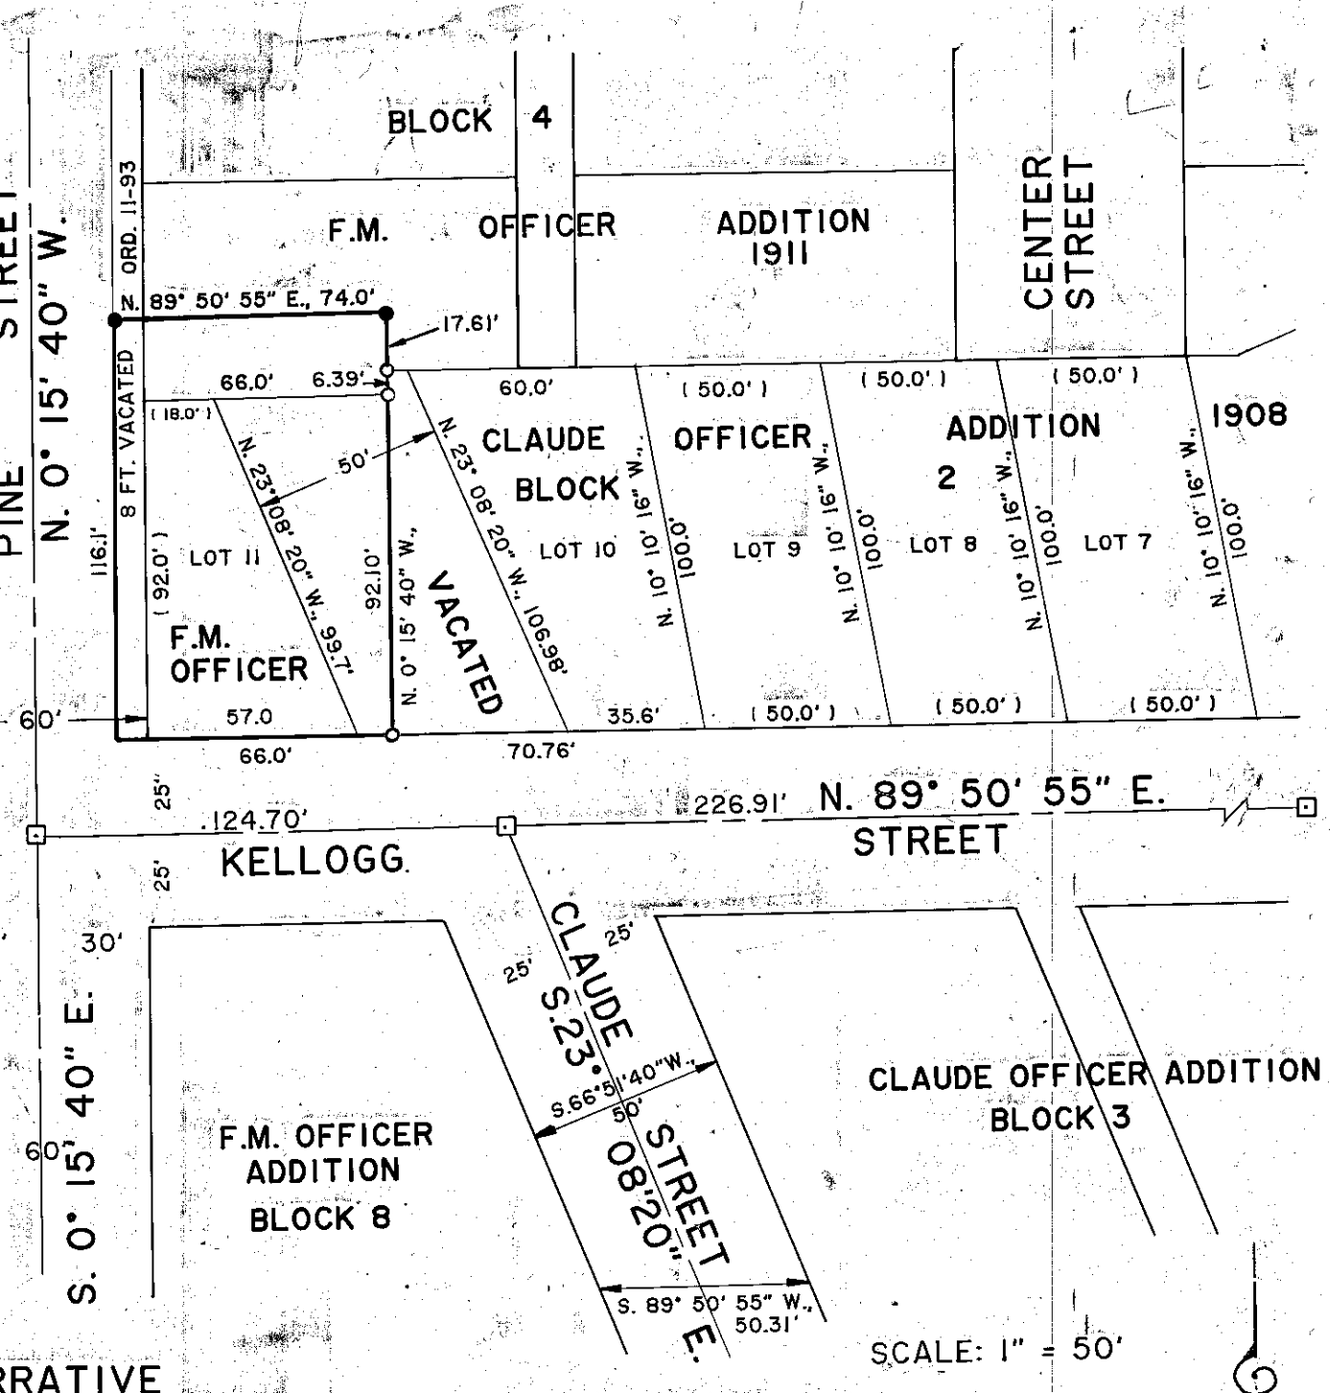

RRATIVE

survey for Edie Wells is to mark on the ground the corners of el in the F.M. Officer Addition obtained from the Halfway Lions This Parcel adjoins previously surveyed Lot 11 and a portion of d Claude Street, filed December 27, 1995, as Survey No. 8-46-65. urvey controls this subject survey, including basis of bearing.

GEND

Set 5/8" X 30" rebar with plastic cap marked "HANLEY ENGR. PLS 1206."

Found city monument in steel case.

Original plat distances.

Found 5/8" rebar w/ Hanley Engr. cap.

MAP OF SURVEY

IN F.M. OFFICERS ADDITION TO HALFWAY, OREGON

Surveyed October 25, 1996.

REGISTERED PROFESSIONAL LAND SURVEYOR
James D. Hanley
OREGON
SEPTEMBER 23, 1977
JAMES D. HANLEY
1206

Renews June 30, 1997

HANLEY ENGINEERING
2043 MAIN STREET
BAKER CITY, OREGON

FILED Dec 6, 1996
BAKER COUNTY SURVEYOR
SURVEY NO. 8-46-72