

PUBLIC LAND SURVEY CORNER RECORD
MALHEUR COUNTY, OREGON

Township 8 S, Range 46 E, Section 23, Corner S 1/4

CORNER EVIDENCE FOUND (INCLUDING ACCESSORIES): _____


CORNER LOCATION DETERMINED USING A PARTITION PLAT DONE BY HANLEY ENGINEERING IN 1993 SURVEY

NO. 8-46-51. FOUND FENCE CORNER AND ROCK JACK AS DESCRIBED IN SURVEY.

Description of New Monument, Accessories, or Changes: _____

SET ALUMINUM CAP WITH FENO MONUMENT. MONUMENT SET FLUSH WITH THE
GROUND AND MARKED AS SHOWN.

Monument Detail

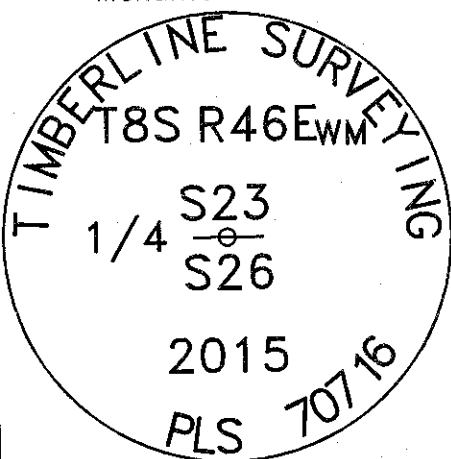

ALUMINUM CAP

Stamp


REGISTERED
PROFESSIONAL
LAND SURVEYOR

7/9/15

OREGON
NOVEMBER 13, 2007
RUSSELL BADGLEY
70716 LS

Exp. 12/31/15

Sketch of General Area and Accessories

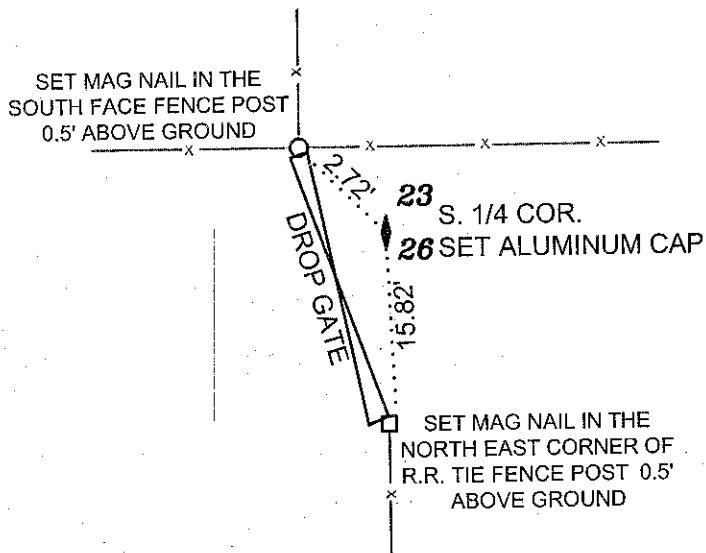


Bus. Name and Address

TIMBERLINE SURVEYING
847 PARCKCENTRE WAY STE. 3
NAMPA, IDAHO 83651

Date of Field Work:

JUNE 30, 2015

Diagram

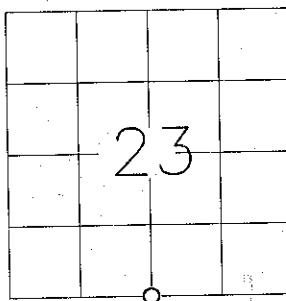

For County Use Only

Received _____

Filed _____

Sur. No. _____

Dwg. No. _____

Index. No. R-19

FILED July 17, 2015

BAKER COUNTY SURVEYOR

SURVEY NO. 8-46-133