

PUBLIC LAND SURVEY CORNER RECORD  
MALHEUR COUNTY, OREGON

Township 8 S, Range 46 E, Section 24, Corner SE


CORNER EVIDENCE FOUND (INCLUDING ACCESSORIES): NO CORNER EVIDENCE FOUND.

FENCE INTERSECTION HELD AS BEST EVIDENCE OF CORNER LOCATION.

Description of New Monument, Accessories, or Changes: \_\_\_\_\_


SET ALUMINUM CAP WITH FENO MONUMENT. MONUMENT SET FLUSH WITH THE  
GROUND AND MARKED AS SHOWN.

Monument Detail

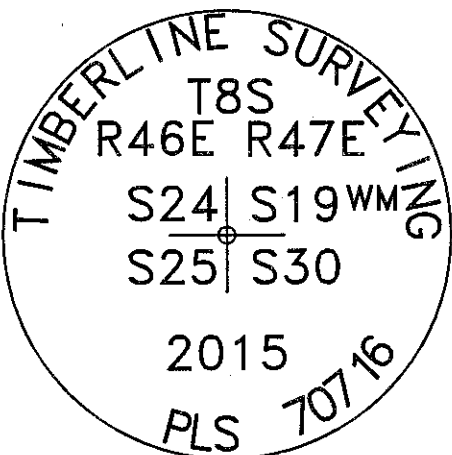


ALUMINUM CAP

Sketch of General Area and Accessories

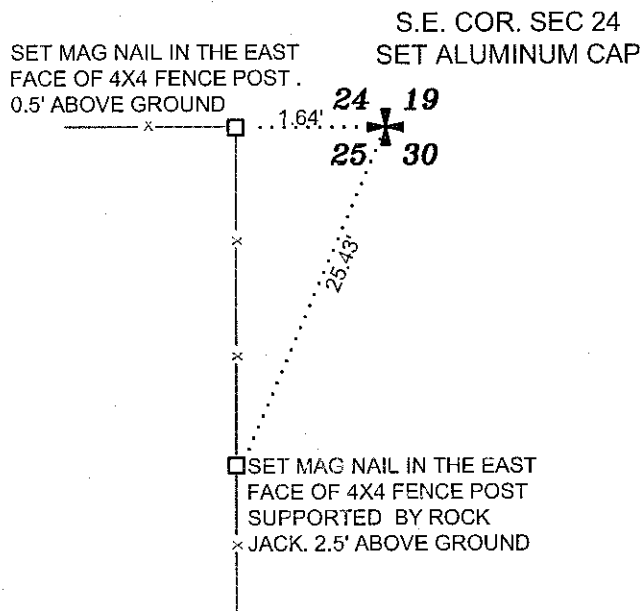

Stamp

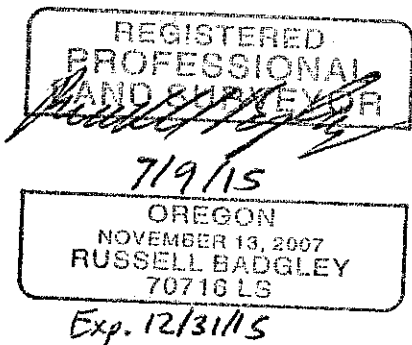


Bus. Name and Address

TIMBERLINE SURVEYING  
847 PARCKCENTRE WAY STE. 3  
NAMPA, IDAHO 83651

Date of Field Work:

JUNE 30, 2015

Diagram

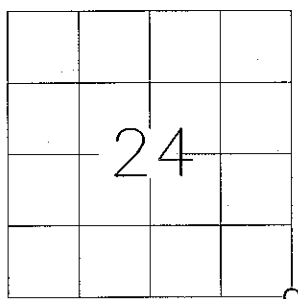

For County Use Only

Received \_\_\_\_\_  
Filed \_\_\_\_\_  
Sur. No. \_\_\_\_\_  
Dwg. No. \_\_\_\_\_  
Index. No. R-25

Filed July 17, 2015

BAKER COUNTY SURVEYOR  
SURVEY NO. 8-46-136/8-47-8