


1955 State of Oregon
 Baker County Oregon
 May 20th 1910 Sect. 100 Ang
 to this last
 A.B. Blackwell
 Surveyor

The Certificate, Plat, or map by L.M. Lloyds
 and Myron Lloyds, his wife, of Baker County,
 Oregon, declared accepted, and published
 to be read and for the place of the 1st Mill
 Baker County Oregon, State of Oregon
 See 17th 8th 5th R. 46 E. 1/4 M. 1
 and Alley shown upon the plat, and survey
 by us are hereby declared to be the same, of the
 Public Streets and Alleys and Public High
 ways.

In no way intended to have, or our heirs
 and assigns, in any day of Dec. 31st 1910

W.B. Blackwell

W.B. Blackwell

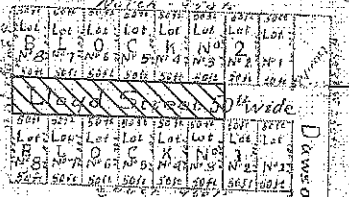

State of Oregon
 County of Baker
 Dawson Street 50ft wide.

December 1910 before the undersigned Notary Public and
 Myron Lloyds Surveyor Oregon Personally appeared J. M. Lloyds and
 Myron Lloyds his wife to me personally known to be the
 foregoing deed of dedication, and each acknowledged to me the
 intent and heretofore that they executed the same freely and for the
 purposes therein expressed.


Witness my hand and seal this 21st day of Dec. 1910
 J. M. Lloyds
 Notary Public for Oregon

W.B. Blackwell County Judge
W.B. Blackwell County Commissioner
James M. ... County Assessor
... County Surveyor

(County of Baker)
 State of Oregon
 I, W.B. Blackwell,
 Being first duly sworn, say that I executed the foregoing Survey
 and Plat of the I.M. Lloyds, First Addition to the Town of Halfway,
 that I marked the initial point of the Survey by driving a 2 inch
 galvanized iron pipe through a diameter Street lying South in the
 Ground, as indicated on the foregoing Plat and tied the same
 to the U. S. N. Sec. Cor. between Secs. 8 and 11th 8th 5th R. 46 E. 1/4 M.

W. B. Blackwell
 Subscribed and sworn to
 Before me this 21st day of Dec. 1910

W.B. Blackwell
 Notary Public for Oregon
 Filed Dec. 12, 1911
W.B. Blackwell
 Clerk

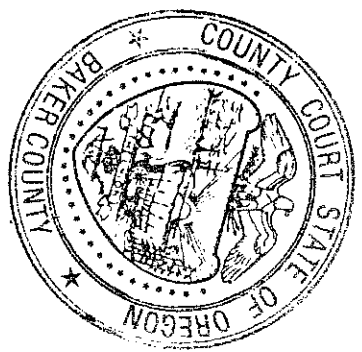

REGISTERED
 PROFESSIONAL
 LAND SURVEYOR

Thomas J. Hanley
 OREGON
 JULY 13, 1979
 THOMAS J. HANLEY
 1817

Renews June 30, 2019

Modified to correct the plat of L.M. Lloyds Addition
 to the City of Halfway reflecting Vacation Ordinance 2018-146
 at the request of Malcolm Champlain
 previously recorded as Book # O Page 11.

STATE OF OREGON, County of Baker, SS
 I hereby certify that I have compared the
 within instrument with the original instru-
 ment now on file in my office, and that it is
 a true and correct copy of the same and of
 the whole thereof.
 Dated 11/6/2018

Cynthia Carpenter, County Clerk
 By Cynthia Carpenter Deputy

FILED November 30, 2018
 BAKER COUNTY SURVEYOR
 BOOK 8-46-157