
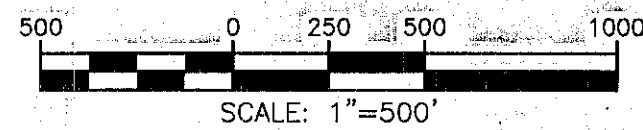


RECORD OF SURVEY FOR IDAHO POWER COMPANY

A PORTION OF SECTIONS 21, 22, 23, & 24,
TOWNSHIP 8 SOUTH, RANGE 46 EAST, W.M.,
BAKER COUNTY, OREGON
-2015-

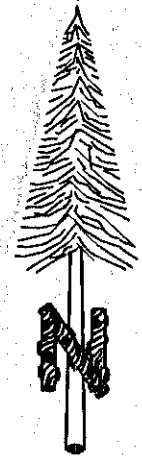

SECTION CORNER
FOUND 2 1/2" BRASS CAP MONUMENT

12 7
13 18

SECTION CORNER
SET ALUMINUM CAP FENO MONUMENT.
CORNER LOCATION DETERMINED BY USING THE GLO RECORD
DIMENSIONS FOR THE WEST AND NORTH LINE OF SECTION 24. I SET
THE RECORD LINEWORK ON THE NORTHWEST CORNER OF SECTION 24
AS DETERMINE BY RECORD MAP 8-46-51 AND THEN ROTATING THE
WEST LINE TO THE FOUND ORIGINAL STONE FOR THE SW CORNER OF
SECTION 24. I THEN HELD THE END OF THE NORTH LINE FOR THE
CORNER LOCATION. THIS LOCATION FITS VERY WELL WITH THE TOPO
CALLS IN THE GLO NOTES. I TRIED OTHER WAYS OF CALCULATING THE
CORNER LOCATION SUCH AS SINGLE PROPORTION ETC. NONE OF THE
OTHER OPT ONS SEEMED TO FIT THE TOPO CALLS.

S02°03'00"E - 5173.54'

13 18
24 19

N1/4 CORNER SECTION 24
NO MONUMENT SET. CORNER LOCATION
DETERMINED BY SINGLE PROPORTION
AFTER THE NORTHEAST CORNER
LOCATION WAS DETERMINED. (R1)(N00°00'E - 39.97CH.)
N86°51'59"E - 2638.35'

1333.19'

1333.19'

2666.38'

1333.19'

1333.19'

24 19

2666.38'

1333.19'

2666.38'

1333.19'

2666.38'

1333.19'

24 19
25 30

SECTION CORNER
SET ALUMINUM CAP FENO MONUMENT.
FENCE INTERSECTION HELD AS BEST
EVIDENCE OF CORNER LOCATION.

SECTION CORNER
SET ALUMINUM CAP FENO MONUMENT
AS A WITNESS CORNER 150' SOUTH.
CORNER LOCATION DETERMINED
USING A PARTITION PLAT DONE BY
HANLEY ENGINEERING IN 1993
SURVEY NO. 8-46-51.

15 14
22 23

(R2)(N89°59'51"E - 2640.62')
(R1)(N89°30'E - 39.87CH.)
N86°39'14"E - 2640.62'

N1/4 CORNER SECTION 23
SET ALUMINUM CAP FENO MONUMENT.
CORNER LOCATION DETERMINED USING A
PARTITION PLAT DONE BY HANLEY
ENGINEERING IN 1993 SURVEY NO. 8-46-51.

14 23

(R2)(N89°59'51"E - 2627.51')
(R1)(N89°30'E - 39.87CH.)
N86°30'35"E - 2627.51'

14 13
23 24

SECTION CORNER
SET ALUMINUM CAP FENO MONUMENT.
CORNER LOCATION DETERMINED USING A
PARTITION PLAT DONE BY HANLEY
ENGINEERING IN 1993 SURVEY NO. 8-46-51.

(R1)(N00°00'E - 39.98CH.)
N86°51'59"E - 2638.35'

13 24

(R1)(N00°00'E - 39.97CH.)
N86°51'59"E - 2638.35'

1319.17'

1319.17'

SEE SHEET 1
N03°09'33"W - 2622.00'
N03°09'33"W - 2622.00'
N03°09'33"W - 2622.00'
N03°09'33"W - 2622.00'

PINETOWN LN.

IPCO EASEMENT
INST. NO. 14490039

1/4 CORNER SECTION 22&23
SET ALUMINUM CAP FENO MONUMENT.
CORNER LOCATION DETERMINED USING A
PARTITION PLAT DONE BY HANLEY
ENGINEERING IN 1993 SURVEY NO. 8-46-51.

22 23

S86°48'18"W - 2635.85'
(R2)(N89°42'26"E - 2635.85')

S 23

C1/4 CORNER SECTION 23
COMPUTED

S86°48'18"W - 2631.04'
(R2)(N89°42'26"E - 2631.04')

N03°09'41"W - 1317.87'

N03°09'41"W - 1317.87'

1315.52'

1315.52'

1/4 CORNER SECTIONS 23&24
SET ALUMINUM CAP FENO MONUMENT.
CORNER LOCATION DETERMINED USING A
PARTITION PLAT DONE BY HANLEY
ENGINEERING IN 1993 SURVEY NO. 8-46-51.

23 24

N87°07'31"E - 2651.17'

IPCO EASEMENT
INST. NO. 14370052

IPCO EASEMENT
INST. NO. 14370056

N86°39'27"E - 1314.63'

N86°39'27"E - 1314.63'

TIMBERLINE SURVEYING
847 PARKCENTRE WAY, SUITE 3, NAMP, IDAHO 83651
P: 208-465-5687 - F: 208-465-5690
FILE: \G:\T\IDAHO POWER\14010.002-Halfway to Brownlee Dam\Halfway-2\Case1 ROS.dwg
JOB NO: 14010.002
SHEET: 2 OF 2
INDEX NO. 8462-23&8462-24

REGISTERED
PROFESSIONAL
LAND SURVEYOR
Russell Badgley
7/17/15
OREGON
NOVEMBER 13, 2007
RUSSELL BADGLEY
70716 LS
Exp: 12/31/15

COUNTY SURVEYOR
RECORDING INFO
Received _____
Filed _____
SURVEY NO. _____
DRAWING NO. _____

1/4 CORNER SECTION 23&26
SET ALUMINUM CAP FENO MONUMENT.
CORNER LOCATION DETERMINED USING A
PARTITION PLAT DONE BY HANLEY
ENGINEERING IN 1993 AND RECORDED
WITH COUNTY SURVEYOR RECORDS AS
8-46-51.

S85°30'58"W - 2635.45'
(R1)(S89°40"W - 39.85CH.)

23 24
26 25

N87°26'31"E - 2664.09'
(R1)(S89°35"E - 39.95CH.)

FILED July 17 2015
BAKER COUNTY SURVEYOR
SURVEY NO. 8-46-121

S1/4 CORNER SECTION 24
SET ALUMINUM CAP FENO MONUMENT.
FOUND STONE 12"X10"X5" WITH NO MARKS
2' EAST OF NORTHSOUTH FENCE LINE.
HELD FOR CORNER LOCATION.

24 25

(R1)(S89°35"E - 39.95CH.)

SECTION CORNER
SET ALUMINUM CAP FENO MONUMENT.
FENCE INTERSECTION HELD AS BEST
EVIDENCE OF CORNER LOCATION.

24 19
25 30