


SURVEY of the SE⁺NW⁺SE⁺ & S⁺NE⁺NW⁺SE⁺
SECTION 24, T9S, R36E ULM
BAKER COUNTY OREGON
US FOREST SERVICE
Scale 1"=1000' Date 8-17-74

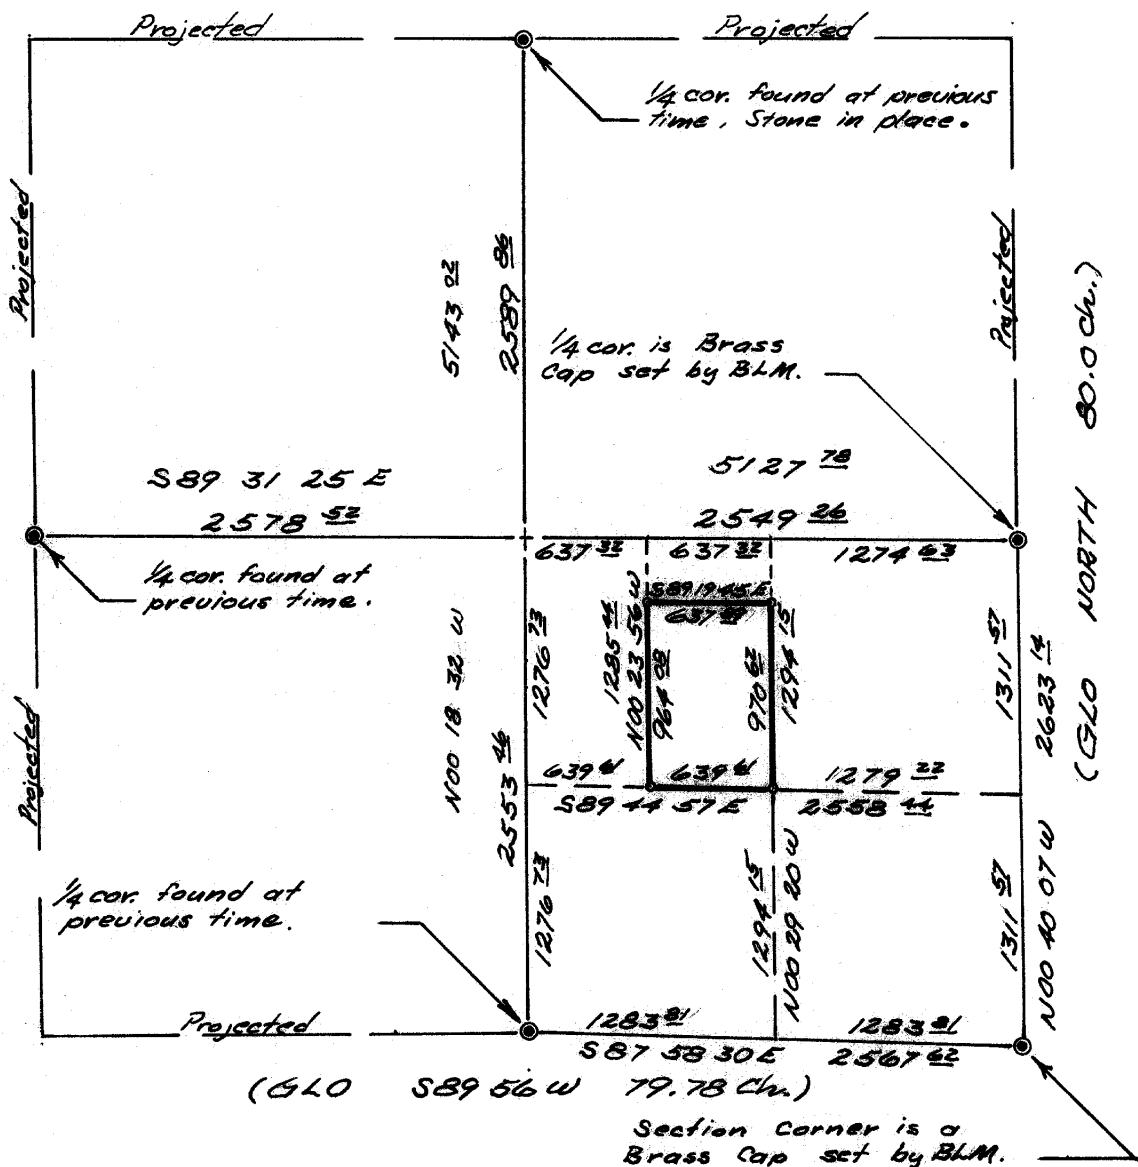

NOTE: True meridian used this survey, was determined by a solar observation.

LEGEND: o Indicates corner set this survey being a 2" x 36" galv. iron pipe w/a 2 1/2" Brass cap.

I, James H. Hambleton, do hereby certify this map is an accurate representation of a survey made by me, during July 1974, using electronic measuring equipment and a theodolite. The corners are monumented and the boundaries marked being authorized by the US Forest Service Baker Oregon.

REGISTERED
PROFESSIONAL
LAND SURVEYOR

James H. Hambleton

FILED 9-4-74
BAKER COUNTY SURVEYOR
SURVEY NO. 9-36-1

OREGON
JULY 10, 1964
JAMES H. HAMBLETON
645