

CERTIFIED RECORD OF LAND CORNER MONUMENTATION


History of original corner establishment:

Mineral Survey No. 480 completed August 2, 1902

Identical with the N.W. corner of the location, set a black pine post 8 in. square 4 ft. long 12 ins. in the ground scribed BRO. C. 1 - 480 with a mound of rocks around it. The N.E. cor. of Sec. 1, T9S, R36E bears N4° 49' E, 982.6 ft.

A black pine tree 8 ins. in diam. bears N5°E, 10.3 ft.

A black pine tree 10 ins. in diam. bears N46° 30'W, 9.8 ft.
both blazed and scribed BRO. C. 1-480 - BT

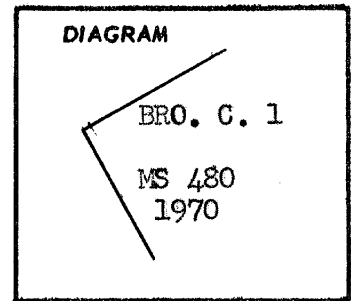

Description of corner evidence found:

I found a rock mound with a small stake marking the corner. The original post was gone as were the bearing trees.

Description of monument and accessories I established to perpetuate the original location of this corner

Set a 5/8" x 30" rebar with a 2" aluminum cap in the rock mound marked as shown above. This survey did not tie to the range line and section corner as the original did.

REGISTERED
PROFESSIONAL
LAND SURVEYOR

Leland Lee Myers

OREGON
JULY 9, 1965
LELAND LEE MYERS
699

Office of County of
State of , I hereby certify that the within instrument was filed in this office
for record on the day of; 19....., at o'clockm., (signed)
..... by
(COUNTY OFFICIAL) (DEPUTY)

FILED Aug. 31, 1977

BAKER COUNTY SURVEYOR
SURVEY NO. 9-36-7