


CERTIFIED RECORD OF LAND CORNER MONUMENTATION

Index File No. L-25

History of original corner establishment:

Corner was originally established by E. McCormack under G. L. O. contract No. 398, during September 28, 1881. Surveyors General's notes state: "Set post 3 ft. long, 3 ins. square 24 ins. in the ground for 1/4 sec. corner marked 1/4S on W. face, from which A pine 36 ins. diam. bears N35°E, 73 lks. dist. marked 1/4S BT. A fir 40 ins. diam. bears S20°E, 76 lks. dist. marked 1/4S BT."

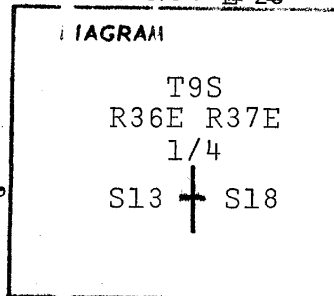

Description of corner evidence found:

Found no trace of record corner post. Found a 40" Pine with burnt upper blaze and no visible scribing. Opened lower blaze and found definite faint B and good T. Measured S35°W, 48.2 ft. and found no trace of Fir BT. Falls near old logging road and may have been pushed from the area.

Field book #3, page

Corner falls 50 ft. north of an old logging road.

Description of monument and accessories established to perpetuate the original location of this corner

At the center of the above described point, set 2 1/2" X 30" galvanized pipe and brass cap marked: Set pipe 24" in the ground and mound of stone around to cap.

From which by magnetic declination of N20°E:

A 14" Fir bears N08°E, 63.8 ft. scribed 1/4S18 BT.

A 9" Pine bears N50°W, 45.0 ft. scribed 1/4S13 BT.

Placed 54-3s and brass washers stamped PLS 1051 on the BTs. Old BT has 54-3 and location tag. Painted blazes red and 6" red band around. Placed 54-4 on a steel fence post 5' North of the corner.

T9S
R36E R37E
1/4
S13 + S18
OR PLS 1051
1979

**REGISTERED
PROFESSIONAL
LAND SURVEYOR**

Barry B. Barbour

OREGON
OCT. 17, 1978
BARRY B. BARBOUR
1051

I hereby certify that the above corner monument was reestablished as herein described.

Witnesses: Daniel T. Rowland
Ronald Gilroy

November 16, 1979

Office of _____ County Surveyor _____ County of _____ Baker
State of _____ Oregon _____, I hereby certify that the within instrument was filed in this office
for record on the 27 day of June 1980.
James D. Hanley by *Tom Hanley*
(COUNTY OFFICIAL) (DEPUTY)

June 27, 1980

FILED June 27, 1980
BAKER COUNTY SURVEYOR
SURVEY NO. 9-36-8