


CERTIFIED RECORD OF LAND CORNER MONUMENTATION

Index File No. R-23

History of original corner establishment:

Corner was originally established by William R. Gradon under G.L.O. contract No. 409, from May 26- June 26, 1882. Surveyor General's notes state "Set post 3 ft. long, 3 ins. sq. 24 ins. in the ground for 1/4 sec. cor. from which: A Fir 18" in diameter bears N85°E, 25 lks. marked 1/4S BT. A Fir 10 ins in diameter bears N55°W, 20 lks. dist. marked 1/4S BT."

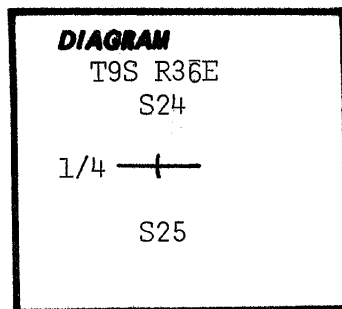

Description of corner evidence found:

Found 20" white for stump, cut part has faint "1/4S" scribing. Measured S15°W, 16.5 ft. from which a down 10" white fir, scribed "1/4S", stump hole of which bears S50°W, 17.8 ft. Probed and found hole from old wood at corner point. No other trace of wood post found.

Corner falls about 200' above track road, above Sumpter Highway.

Description of monument and accessories I established to perpetuate the original location of this corner:

At above described point set 2 1/2" X 30" galvanized pipe and brass cap marked: Set pipe 25" in the ground and placed a few rocks around.

From which by magnetic declination of N20°E:

A 16" Tamarac bears S30°W, 44.5 ft. scribed

1/4 S25 BT. A 12" Tamarac bears N22°W, 65.6 ft.


scribed 1/4S24 BT. Painted blazes red and 6" red band

around. Placed 54-3s and brass washers stamped PLS 1051 on BTs. Placed 54-4 on steel fence post 5' East of the corner.

T9S R37E
S24

1/4 ———+————

S25
OR PLS 1051
1980

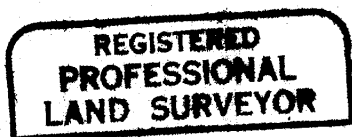

Barry B. Barbour
OREGON
OCT. 17, 1978
BARRY B. BARBOUR
1051

I hereby certify that the above corner monument was reestablished as herein described.

Witnesses: Daniel T. Rowland
Robert Boling

May 23, 1980

Office of...County...Surveyor..... County of.....Baker.....
State of....Oregon....., I hereby certify that the within instrument was filed in this office
for record on the.....27 day of.....June....., 1980.
.....*James D. Hanley*..... by*Tom Hanley*.....
(COUNTY OFFICIAL) (DEPUTY)

Form R6-7100-57 (9/71)

June 27, 1980

FILED June 27, 1980

BAKER COUNTY SURVEYOR

SURVEY NO. 9-36-13

☆ GPO—798-276