

CERTIFIED RECORD OF LAND CORNER MONUMENTATION

History of original corner establishment:

Corner was established in 1882 by William R. Graddon, Deputy surveyor under contract No. 409. Surveyor General's records state: Set a basalt stone 12" x 9" x 6", 8" in ground, mkd. $\frac{1}{4}$ " on the North face, from which:
A Pine 24" dia. bears N 45 W, 83 lks. dist. mkd. $\frac{1}{4}$ " S BT.
A Pine 24" dia. bears S 10 W, 32 lks. dist. mkd. $\frac{1}{4}$ " S BT.

DIAGRAM

Cap Stamped:

T 9 S
 $\frac{1}{4}$ S 13
 $\frac{1}{4}$ S 24
R 36 E
1981
ORLS 645

Description of corner evidence found:

At the assumed $\frac{1}{4}$ corner location I found a basalt stone 12" x 9" x 7" lying on surface of ground with $\frac{1}{4}$ " marked on the North face of the stone from which I also found:

A stump hole with evidence of burnt pine bark and pine wood, which bears N 45 W, 53.78 ft. (83 lks.) dist. from above described stone.
A rotted pine stump approximately 32", which bears S 10 W, 21.12 ft. (32 lks.) dist. with evicence of the overgrowth of the face remaining.


Description of monument and accessories I established to perpetuate the original location of this corner:

With the above evidence correspongning to the desscription set forth in the Surveyor Generals records, I then set a $2\frac{1}{2}$ " brass cap on a 30" galv. iron pipe at the $\frac{1}{4}$ corner location. I buried the pipe leaving 3" above the surface, and placed the original stone upside down on the east side of the pipe with the $\frac{1}{4}$ mark facing the pipe. I then placed a small mound of stone about the cap and covering the cap, from which I set two new bearing trees:

A pine 12" dia. bears N 73 E, 27.5 feet and scribed $\frac{1}{4}$ " S. BT.
A Pine 11" dia. bears S 59 E, 36.6 feet and scribed $\frac{1}{4}$ " S BT.

I hereby certify the above corner monument was re-established as herein described during October 1981.

Witness Catherine M. Hambleton
Catherine M. Hambleton

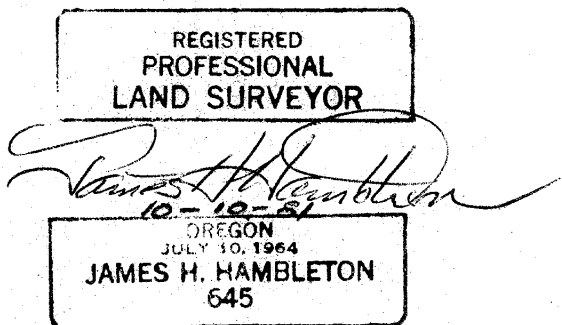

Office of..... County Surveyor County of..... Baker
State of..... Oregon I hereby certify that the within instrument was filed in this office
for record on the..... 16 day of..... October , 1981!
..... by
(COUNTY OFFICIAL) (DEPUTY)