

CERTIFIED RECORD OF LAND CORNER MONUMENTATION

History of original corner establishment:

Set 4" x 4" post from which a:

- 18" Fir bears N 55° E 16 lks dist.
- 10" Fir bears S 70° E 37 lks dist.
- 10" Fir bears S 20° W 21 lks dist.
- 12" Fir bears N 23° W 32 lks dist.

Set from 1882 survey by William R. Gradon under contract with the General Land Office

DIAGRAM

T9S R36E	
S27	S26
S34	S35
1982	
PLS 1305	

Description of corner evidence found:

- 17" W. Fir bears N 23° W 21.1 ft. - visible scribing
- Rotted stub bears East (N 55° E record) 10.6 ft. - visible scribing
- SW BT now 8 ft. rotted snag bears S 20° W 13.9 ft. - visible scribing
- Found sliver of scribing at approx. SE BT

Description of monument and accessories | established to perpetuate the original location of this corner:



Set 2 $\frac{1}{2}$ " brass cap in 2 $\frac{1}{2}$ " x 30" G.I. pipe with flared base - rock mound,
marked as per diagram above

Scribed BTs:

- 8" L.P. Pine bears N 10° W 5.4 ft., scribed T9S R36E S27 BT
- 11" W. Fir bears N 45° E 43.3 ft., scribed T9S R36E S26 BT
- 13" W. Fir bears S 31° E 51.1 ft., scribed T9S R36E S35 BT
- 6" W. Fir bears S 20° W 49.3 ft., scribed T9S R36E S34 BT

I hereby certify the above corner monument was re-established as herein described on August 16, 1982

Witnesses: Dave Dean
Richard Carter

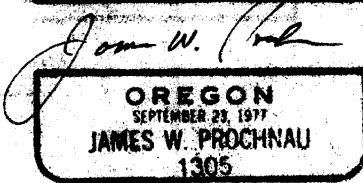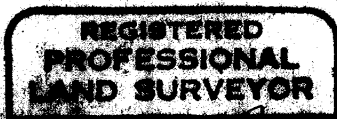

Office of..... County of.....
State of....., I hereby certify that the within instrument was filed in this office
for record on the..... day of....., 19.....
..... by
(COUNTY OFFICIAL) (DEPUTY)