

CERTIFIED RECORD OF LAND CORNER MONUMENTATION

History of original corner establishment:

Original Survey by William R. Gradon under contract # 409 dated March 28 1882.

Set a basalt stone 16x10x6 ins 11 ins in the ground for $\frac{1}{4}$ sec cor marked $\frac{1}{4}$ on W face from which

A pine 8 ins diam bears S80° E 20 lks dist. marked $\frac{1}{4}$ S BT

A pine 4 ins diam bears S65° W 5 lks dist. marked $\frac{1}{4}$ S BT

DIAGRAM

T9S R 36E
S34 | S35

Description of corner evidence found:

At the corner I found a 16"x10"x6" stone lying on the ground marked $\frac{1}{4}$.

At S80° E 13.2 ft is a down and rotting 10" lodgepole pine marked $\frac{1}{4}$ S BT

The other BT is completely gone

Description of monument and accessories I established to perpetuate the original location of this corner:

After checking the position of the original stone from the remaining BT I set a 2 $\frac{1}{2}$ "x32" aluminum capped aluminum pipe 28" in the ground in a mound of stone from which

A 6" White Fir bears S25° W 47.68 ft
marked $\frac{1}{4}$ S 34BT nail in E base

A 10" Lodgepole pine bears N37° E 14.81 ft
marked $\frac{1}{4}$ S35BT nail in W base


Bearings taken with a staff compass declination 18 $\frac{1}{2}$ ° East per 1980 Isogonic chart

Distance pulled to 60d nail with Brass washer stamped LS 1898 driven in the side center of the bearing trees.

I hereby certify the above monument was re-established as here-in described on July 20 1983.

MONUMENT STAMPED

T9S, R36E
S34 $\frac{1}{4}$ S35
1983
O.R.LS. 1898

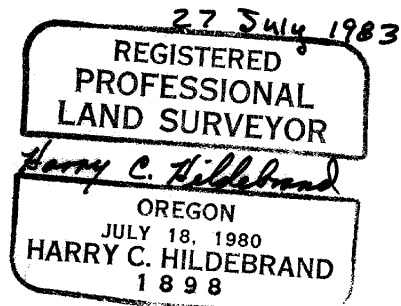

Office of.....Surveyor..... County of...Baker.....
State of.....Oregon....., I hereby certify that the within instrument was filed in this office
for record on the..... day of....., 19.....
..... by
(COUNTY OFFICIAL) (DEPUTY)

Form R6-7100-57 (9/71)

FILED July 28, 1983
BAKER COUNTY SURVEYOR
SURVEY NO. 9-36-17

☆ GPO—798-276
X-17