

CERTIFIED RECORD OF LAND CORNER MONUMENTATION

History of original corner establishment:

Original survey by William R. Gradon under contract # 409 dated March 28 1882
Set a basalt stone 16x9x5 ins 11 ins in the ground for $\frac{1}{4}$ Sec cor marked $\frac{1}{4}$ on W face from which
An Alder 4 ins diam bears N55° E 13 lks dist marked $\frac{1}{4}$ S BT
A Fir 14 ins diam bears N80° W 46 lks dist marked $\frac{1}{4}$ S BT

DIAGRAM

T9S	R36E
S33	S34

Description of corner evidence found:

At the corner loaction I found no evidence of the original stone. The corner falls on a very steep slope and it might have rolled down the hill, 18" Fir stump and remains of rotted tree bears N80° W 30.4 ft marked $\frac{1}{4}$ S BT.

There is no remaining evidence of the Alder tree

Description of monument and accessories I established to perpetuate the original location of this corner:

From the remaining BT I set a 2 $\frac{1}{2}$ "x32" Brass capped steel pipe 6" in the ground in a large mound of stone from which:
A 6" White Fir bears N88° W 14.82 ft
mkd $\frac{1}{4}$ S 33 BT nail in S base
A 6" White Fir bears S80° E 56.74 ft
mkd $\frac{1}{4}$ S 34 BT nail in S base


MONUMENT STAMPED

T 9 S	R 36 E
S 33	S 34
1983	
O.R.L.S. 1898	

Bearings taken with staff compass
declination 18 $\frac{1}{2}$ ° East per 1980
Isogonic chart.

Distances pulled to 60d nail with
Brass washer stamped LS 1898
driven in the side center of the
bearing trees

I hereby certify the above corner
monument was re-established are herein described on 19 July 1983.

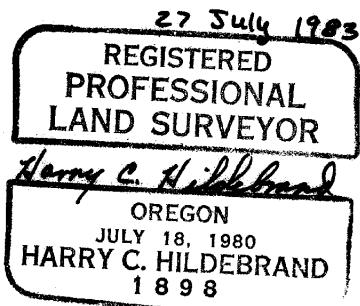

Office of..... Surveyor..... County of..... Baker.....
State of..... Oregon....., I hereby certify that the within instrument was filed in this office
for record on the..... day of....., 19.....
..... by
(COUNTY OFFICIAL) (DEPUTY)

Form R6-7100-57 (9/71)

FILED July 28, 1983
BAKER COUNTY SURVEYOR
SURVEY NO. 9-36-18

☆ GPO—798-276
X-13