


CERTIFIED RECORD OF LAND CORNER MONUMENTATION

**History of original corner establishment:**

Original Survey by Eugene P. McCornack under contract # 398 dated July 2 1881  
Set Basalt stone 12x10x10 ins 8 ins in the ground for  $\frac{1}{4}$  sec cor marked  $\frac{1}{4}$  on W face from which

A Fir 14 ins diam bears N45° E 8 lks dist marked  $\frac{1}{4}$  S BT

A Fir 8 ins diam bears S80° W 50 lks dist marked  $\frac{1}{4}$  S BT

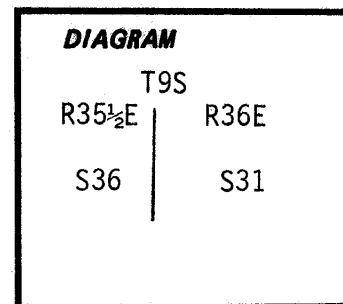

**Description of corner evidence found:**

At the corner location I could not find the original stone this is a steep side slope and the stone might have rolled down the hill.

A 14" stump bears N45° E at a distance of 5.3 ft marked BT also the tree is lying beside the stump marked  $\frac{1}{4}$ S

The S 80° W BT is an uprooted rotted tree marked  $\frac{1}{4}$  S BT

**Description of monument and accessories I established to perpetuate the original location of this corner:**

From the solid bearing tree stump and the root hole of the second B.T. I set a 2 $\frac{1}{2}$ x32" Brass capped steel pipe 18" in the ground in a large mound of stone from which ;

An 8" Ponderosa Pine bears S86° 30' W 20.97 ft  
mkd  $\frac{1}{4}$  S 36 BT nail in S base

An 8" Ponderosa Pine bears N29° E 19.05 ft  
mkd  $\frac{1}{4}$  S 31 BT nail in N base


Monument Stamped

|                     |                             |              |
|---------------------|-----------------------------|--------------|
| R35 $\frac{1}{2}$ E | T9S<br>$\frac{1}{4}$<br>S36 | R 36E<br>S31 |
|                     | 1983                        |              |
|                     | ORLS 1898                   |              |

Bearings taken with staff compass declination 18 $\frac{1}{2}$ ° East per 1980 Isogonic chart

Distances pulled to 60d nail with brass washer stamped LS 1898 driven in the side center of bearing trees.

I hereby certify the above monument was re-established as herein described on July 19, 1983.

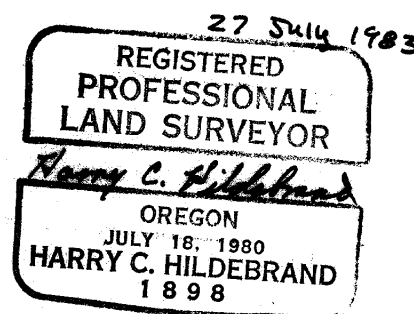

Office of.....Surveyor..... County of...Baker.....  
State of.....Oregon....., I hereby certify that the within instrument was filed in this office  
for record on the..... day of....., 19.....  
..... by .....  
(COUNTY OFFICIAL) (DEPUTY)

Form R6-7100-57 (9/71)

FILED July 28 1983

BAKER COUNTY SURVEYOR

SURVEY NO. 9-36-21

9-35 $\frac{1}{2}$ -3

☆ GPO—798-276

X-25