

CERTIFIED RECORD OF LAND CORNER MONUMENTATION

History of original corner establishment:

Original survey by Eugene P. McCornack under contract
No. 409 dated March 28, 1882
Set a post 3 ft long 3 ins square 24 ins in the ground
for $\frac{1}{4}$ Sec cor. marked $\frac{1}{4}$ S on N face from which

A pine 40 ins diam bears N20° W 48 lks dist marked $\frac{1}{4}$ SBT

A fir 12 ins diam bears S30° W 50 lks dist marked $\frac{1}{4}$ S BT

DIAGRAM

T9S R 36E

S 25

S 36

Description of corner evidence found:

At the corner location I found no evidence of the original post.

N 20° W A 30" standing live Ponderosa pine marked $\frac{1}{4}$ S BT at a
distance of 31.7 ft.

S 30 W an 18" dead and down Fir marked $\frac{1}{4}$ SBT at a distance of
33.0 ft..

**Description of monument and accessories I established to perpetuate the
original location of this corner:**

At the intersect of the 2 bearing trees I set a 2 $\frac{1}{2}$ "x32"
aluminum capped aluminum pipe 26" in the ground in
a mound of earth from which

A 6" Lodgepole pine bears N35° E 36.95 ft
marked $\frac{1}{4}$ S 25 BT nail in W base

A 7" Lodgepole pine bears S14° E 55.47 ft
marked $\frac{1}{4}$ S 36 BT nail in E base

Bearings taken with a staff compass
declination 18 $\frac{1}{2}$ ° East per 1980 Isogonic chart

Distances pulled to 60d nail with a Brass
washer stamped LS 1898 driven in the
side center of the bearing trees.

I hereby certify that the above monument
was re-established as herein described
on August 3 1983.

MONUMENT STAMPED

T 9 S R 36 E

S 25


$\frac{1}{4}$

S 36

1983

ORLS 1898

8 August 1983

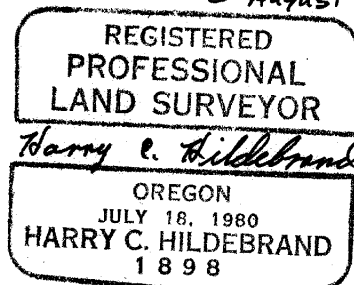

Office of... Surveyor... County of... Baker
Oregon
State of... , I hereby certify that the within instrument was filed in this office
for record on the... day of... , 19....
by
(COUNTY OFFICIAL) (DEPUTY)