

CERTIFIED RECORD OF LAND CORNER MONUMENTATION

History of original corner establishment:

Original Survey by William R. Gradon under contract
No. 409 dated March 28, 1882

Set a basalt stone 14x8x6 ins 9 ins in the ground
for $\frac{1}{4}$ sec. cor. marked $\frac{1}{4}$ on W face from which

A Pine 30 ins diam bears S55° E 28 lks dist mkd $\frac{1}{4}$ S BT
A Pine 20 ins diam bears West 42 lks dist mkd $\frac{1}{4}$ S BT

DIAGRAM

T9S R36E
S22 | S23

Description of corner evidence found:

At the corner location found at 14x8x6 on the ground in the proper location
marked $\frac{1}{4}$ on West face.

A standing live 30" Ponderosa pine bears S89° W 27.7 ft marked $\frac{1}{4}$ S BT
The S55° W BT at 18.5 ft falls in the middle of a road so it has
been destroyed.

**Description of monument and accessories I established to perpetuate the
original location of this corner:**

At the original stone position I set a 2 $\frac{1}{2}$ "x32"
aluminum capped aluminum pipe 28" in the ground
in a mound of earth from which
A 6" White fir bears S60° 30'E 22.41 ft
marked $\frac{1}{4}$ S 23BT nail in N base
A 30" Ponderosa Pine bears S89° W 27.7 ft
marked $\frac{1}{4}$ S BT original BT.

Bearings taken with a staff compass
declination 18 $\frac{1}{2}$ ° East per 1980 Isogonic chart.


Distances pulled to 60d nail with Brass
washer stamped LS 1898 driven in the side
center of the bearing trees.

I hereby certify that the above monument
was re-established as herein described
on August 8, 1983

MONUMENT STAMPED

T9S R36E
 $\frac{1}{4}$
S22 | S23
1983
ORLS 1898

7 sept. 1983

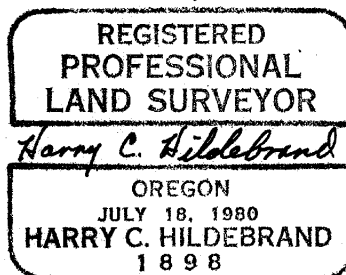

Office of.....Surveyor..... County of...Baker.....
State of.....Oregon....., I hereby certify that the within instrument was filed in this office
for record on the..... day of....., 19.....
..... by
(COUNTY OFFICIAL) (DEPUTY)