

CERTIFIED RECORD OF LAND CORNER MONUMENTATION

C-25


History of original corner establishment:

Corner established by Eugene P. McCornack under GLO contract no. 398 dated July 2, 1881.

Surveyor General records state:

Set post 3 ft long 3 ins square 24 ins in the ground for $\frac{1}{4}$ sec cor marked $\frac{1}{4}$ S on W face from which:

A fir 8 ins diam bears N 40° E, 10 lks dist marked $\frac{1}{4}$ SBT
A fir 8 ins diam bears N 50° W, 5 lks dist marked $\frac{1}{4}$ SBT

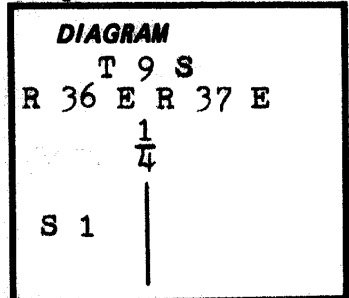

Description of corner evidence found:

Section 1 bearing tree is a green fir 14 ins diam with healed blaze.

~~Section~~ other bearing tree is a dead 18 inch fir with healed blaze.

Description of monument and accessories I established to perpetuate the original location of this corner:

At position established by distance intersection from the above described original accessories, set a $2\frac{1}{2}$ inch aluminum cap on a 2 inch aluminum pipe 31 inches long and projecting 6 inches out of the ground with a surrounding rock mound. Placed a 6 foot steel fence post alongside with a sign 54-9 attached.

Aluminum cap marked thus:

```

      T 9 S
    R36 E R 37 E
      |
      1/4
      |
    S 1
      |
    1984
    ORLS 1639
  
```

A new bearing tree was established in unsurveyed section 6 and is described thus:

A fir 9 ins diam bears S 18° E, 8.0 ft dist marked X BT


The original accessories and the new bearing tree have signs 54-3 and 54-9 attached below a 6 inch band of red paint around. The new bearing tree also has a brass washer marked PLS 1639 nailed flush with BT blaze.

I hereby certify that the above described corner monument was properly established under my supervision on Sept. 27, 1984 by Jim DeMastus and D.

Schuchardt Office of.....Surveyor.....County of.....Baker.....

State of.....Oregon....., I hereby certify that the within instrument was filed in this office for record on the.....11..... day of.....June....., 1985

..... by
(COUNTY OFFICIAL) (DEPUTY)

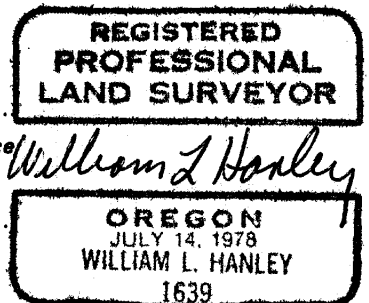

Form R6-7100-57 (9/71)

FILED June 11, 1985
BAKER COUNTY SURVEYOR
SURVEY NO. 9-36-26