

CERTIFIED RECORD OF LAND CORNER MONUMENTATION

History of original corner establishment:

Corner established by Eugene P. McCornack under GLO contract no. 398 dated July 2, 1881.


Surveyor General records state:

Set post 3 ft long 3 ins square 24 ins in the ground for $\frac{1}{4}$ sec cor marked $\frac{1}{4}$ S on N face from which;

A fir 20 ins diam bears S 45° E, 27 lks dist marked $\frac{1}{4}$ S BT

A fir 8 ins diam bears S 45° W, 28 lks dist marked $\frac{1}{4}$ S BT

G-25

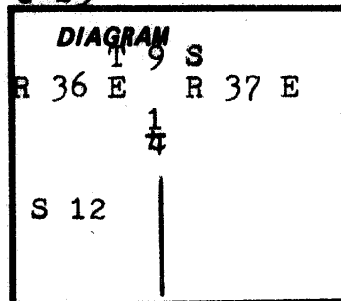

Description of corner evidence found:


A 19 inch fir with healed blaze for section 12 bearing tree.

A fir stump 28 ins diam with BT scribe visible for other bearing tree.
(NOTE: By using distance intersection for corner location it was found that the bearing to this tree should be S 24° E.)

Description of monument and accessories I established to perpetuate the original location of this corner:

At position established by distance intersection from the above described accessories set a $2\frac{1}{2}$ inch aluminum cap on a 2 inch aluminum pipe 31 inches long and projecting 4 inches out of the ground with a surrounding rock mound. Placed a 6 foot steel fence post alongside with a sign 54-9 attached.

Aluminum cap marked thus:

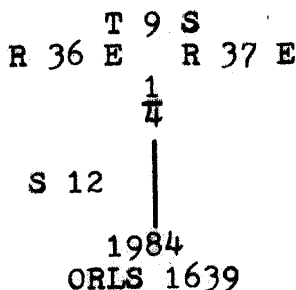

New bearing tree:

A tamarack 9 ins diam bears N 77° E, 29.8 ft dist marked X BT and has a brass washer marked PLS 1639 nailed flush with BT blaze.

Each bearing tree and stump has a sign 54-3 and sign 54-9 attached below a red band of paint around.

I hereby certify that the above described corner monument was properly established under my supervision on Sept. 27, 1984, and witnessed by Jim DeMastus and Daryl Schuchardt.

Surveyor

Baker

Office of..... County of.....
State of **Oregon** , I hereby certify that the within instrument was filed in this office
for record on the 11 day of June , 1985

(COUNTY OFFICIAL)

(DEPUTY)

